

MISSISSIPPI DEPARTMENT OF NATURAL RESOURCES

Bureau of Land and Water Resources

Southport Mall

P.O. Box 10631

Jackson, Mississippi 39209

WATER WELL DRILLERS LOG

PEARL RIVER
D 2001

7-18 19 86 Frank Price Pearl River
date well completed firm name county well located

LANDOWNER:
Ronald Breland


(mailing address)

WELL LOCATION:
sec. 7 T. 1 S. R. 14 E.
2 miles S of Lamberton
(distance) (direction) (nearest town)

WELL PURPOSE: HOME
(home, irrigation, municipal, industrial)

WELL COMPLETION DATA:
(1) diameter (inches) 2"
(2) total depth (feet) 112'
(3) static water level (feet) 20' below above top of ground.
(4) casing PVC, 107',
(material) (depth)
(size) If telescope see back.
(5) screen 107',
(length) (depth to top)
5" PVC
(size) (material)
(6) pump 1 10
(HP) (yield gpm)
Elect.
(type power)
(7) electric log No.
(yes or no)
(organization running log)
(8) how well bottom plugged B.W.F.

description of formations encountered	from	to
<u>Top Soil</u>	<u>0</u>	<u>2</u>
<u>Clay</u>	<u>2</u>	<u>20</u>
<u>Sand & gravel</u>	<u>20</u>	<u>28</u>
<u>Clay</u>	<u>28</u>	<u>89</u>
<u>Course Sand</u>	<u>89</u>	<u>112</u>

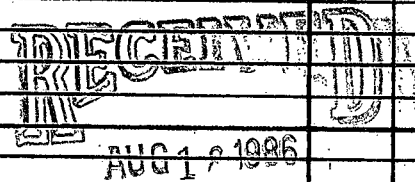


Department of Natural Resources
Bureau of Land & Water Resources

DRILLERS REMARKS:

If well telescopes please sketch and show depths.

GROUND LEVEL

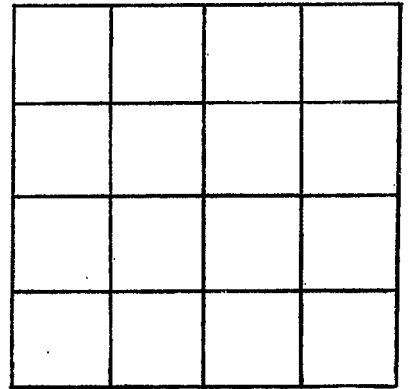

SECTION _____

Please indicate well location X.

ADDITIONAL INFORMATION

If more than one screen,
show locations of each on sketch.