

MISSISSIPPI DEPARTMENT OF NATURAL RESOURCES  
 Bureau of Land and Water Resources  
 Southport Mall  
 P.O. Box 10631  
 Jackson, Mississippi 39209  
**WATER WELL DRILLERS LOG**

Lane Linn  
D 2023

2/4 1987 Budgenton Pearl River  
 Date well completed firm name county well located  
Water Well Service

LANDOWNER: Larry Odens  
R T 5 Box 299  
Lumberton miss  
 (mailing address)

description of formations encountered	from	to
<u>Red Shale</u>	<u>0</u>	<u>80</u>
<u>White Shale</u>	<u>80</u>	<u>156</u>
<u>White Sand</u>	<u>156</u>	<u>176</u>

WELL LOCATION:  
 sec 30 T 5 N R 14 E  
 S W  
12 miles north Andrew  
 (distance) (direction) (nearest town)

WELL PURPOSE: home  
 (home, irrigation, municipal, industrial)

WELL COMPLETION DATA:


- (1) diameter (inches) 4
- (2) total depth (feet) 176
- (3) static water level (feet) 80 below above-top of ground.
- (4) casing pvc, 176,  
 (material) (depth)  
 (size) If telescope see back.
- (5) screen 10, 166  
 (length) (depth to top)  
12, pvc  
 (size) (material)
- (6) pump 1, 900  
 (HP) (yield gpm)  
Elect  
 (type power)
- (7) electric log no  
 (yes or no)
- (organization running log)
- (8) how well bottom plugged sand  
spore

**RECEIVED**  
 JUN 12 1987  
 Department of Natural Resources  
 Bureau of Land & Water Resources

DRILLERS REMARKS:

If well telescopes please sketch and show depths.

GROUND LEVEL

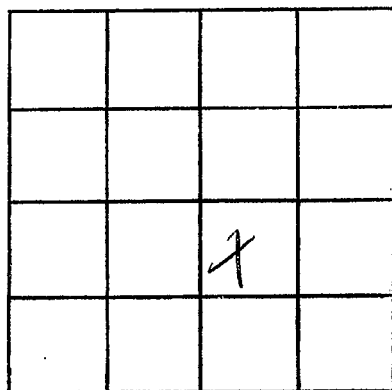

SECTION \_\_\_\_\_

Please indicate well location X.

ADDITIONAL INFORMATION

If more than one screen, show locations of each on sketch.