

MISSISSIPPI DEPARTMENT OF NATURAL RESOURCES

Bureau of Land and Water Resources

Southport Mall

P.O. Box 10631

Jackson, Mississippi 39209

WATER WELL DRILLERS LOG

Paul Lora
D 2024

2/4
date well completed

19 87 Bred Penton
firm name

Pearl River
county well located

LANDOWNER: Paul Allen
R.F. 5 Box 233e
Lumberton Miss
(mailing address)


| description of formations encountered | from | to |
|---------------------------------------|------------|------------|
| <u>Red shale</u> | <u>0</u> | <u>30</u> |
| <u>Bred sand</u> | <u>30</u> | <u>63</u> |
| <u>White & Blue shale</u> | <u>63</u> | <u>400</u> |
| <u>Gray sand</u> | <u>400</u> | <u>460</u> |

WELL LOCATION:
sec 30 T 5 N R 14 E
S W
14 miles North of Pearl River
(distance) (direction) (nearest town)

WELL PURPOSE: Home
(home, irrigation, municipal, industrial)

WELL COMPLETION DATA:

- (1) diameter (inches) 4"
- (2) total depth (feet) 462
- (3) static water level (feet) 170 below top of ground.
- (4) casing pvc 170
(material) (depth)
- (size) if telescope see back.
- (5) screen 10 452
(length) (depth to top)
- 12 pvc
(size) (material)
- (6) pump 1 700
(HP) (yield gpm)
- Elect
(type power)
- (7) electric log no
(yes or no)

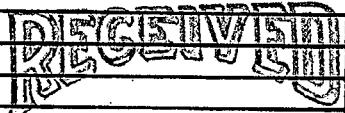

JUN 12 1987


Department of Natural Resources
Bureau of Land & Water Resources

(organization running log)
(8) how well bottom plugged Sand
dash

DRILLERS REMARKS:

If well telescopes please sketch and show depths.

GROUND LEVEL

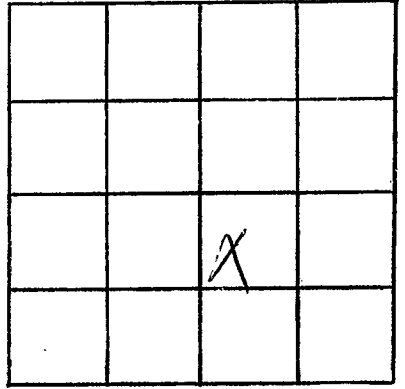

SECTION _____

Please indicate well location X.

ADDITIONAL INFORMATION

If more than one screen, show locations of each on sketch.