

MISSISSIPPI DEPARTMENT OF NATURAL RESOURCES

Bureau of Land and Water Resources

P.O. Box 10631

Jackson, Mississippi 39209

WATER WELL DRILLERS LOG

COUNTY WELL LOGGED	
<u>Pone River</u>	
WELL NUMBER	CODED
<u>D 2025</u>	
DATE WELL COMPLETED	
<u>Nov 12-1987</u>	

PERMIT NUMBER
NAME OF DRILLING FIRM
<u>Cochran Water Well Service</u>

NAME & MAILING ADDRESS OF LANDOWNER			
<u>Jeff James</u>			
<u>RS1</u>			
<u>Sumberton</u>			
WELL LOCATION: SEC	TOWNSHIP	RANGE	
<u>2</u>	<u>1</u>	<u>N 14 E</u>	<u>14</u>
DISTANCE	DIRECTION	NEAREST TOWN	
<u>5</u> Miles	<u>SE</u>	of <u>Sumberton</u>	
OTHER LANDMARK			
WELL PURPOSE: <input checked="" type="checkbox"/> Home, <input type="checkbox"/> Irrigation, <input type="checkbox"/> Municipal, <input type="checkbox"/> Industrial, <input type="checkbox"/> Fish Pond, etc.			

PUMP DATA		
PUMP TYPE (Circle One):		
Submersible,	Turbine,	<u>Jet</u> Flowing Well,
Other (Describe)		
POWER TYPE (Circle One):		
<u>Electric</u> ,	Tractor,	Diesel, Gasoline, Butane,
Other (Describe)		
Pump Capacity (GPM)	No. of Stages	Setting Depth
<u>7</u>	<u>2</u>	<u>35</u> FT.
PUMP TEST		
Well yielded _____ GPM with		
a drawdown of _____ ft.		
after _____ hours of pumping		

WELL DATA		
Well Depth	Casing Diameter (In.)	Casing Length (Ft.)
<u>40'</u>	<u>2</u>	<u>35</u>
Type of Casing	Hole Depth	Depth to Static Water Level
<u>PVC</u>	<u>40</u>	<u>21'</u>
TYPE OF COMPLETION: (Circle One or More):		
<input checked="" type="checkbox"/> Gravel Packed,	<input type="checkbox"/> Underreamed,	<input type="checkbox"/> Telescoped,
<input checked="" type="checkbox"/> Natural Development,	<input type="checkbox"/> Open Hole,	<input type="checkbox"/> Other
(Describe)		
Top of Lap Pipe or Reduction in Casing		
FEET <input type="checkbox"/> IF TELESCOPED OR MORE THAN ONE SCREEN: USE BACK PAGE		

LOG DATA	
TYPE OF LOG RUN (Circle One):	
<input type="checkbox"/> Electric,	<input type="checkbox"/> Gamma Ray, Density, Sonic, Neutron,
Other (Describe)	
Name of Organization Running Log	
<u>No Log Run,</u>	

SCREEN DATA		
Diameter - Inches	Length - Feet	Slot Size - Inches
Screen Type	Depth to Bottom - Feet	


GEOLOGIC DATA (Office Use Only)			
Surface Elev.	Geologic Unit	Unit Thickness	Depth to Top
Subs. SWL	Date	Analysis	Aquifer Test
Driller's Remarks			
RECEIVED			

DESCRIPTION OF FORMATIONS ENCOUNTERED	FROM	TO	FORMATIONS (Continued)	FROM	TO
<u>TOP soil</u>	<u>0</u>	<u>2</u>	<u>Department of Natural Resources</u>		
<u>red clay</u>	<u>2</u>	<u>6</u>	<u>Division of Lands & Water</u>		
<u>sandy clay</u>	<u>6</u>	<u>12</u>			
<u>sand</u>	<u>12</u>	<u>40</u>			

IF MORE SPACE IS NEEDED, USE BACK

If well telescopes please sketch and show depths.

GROUND LEVEL

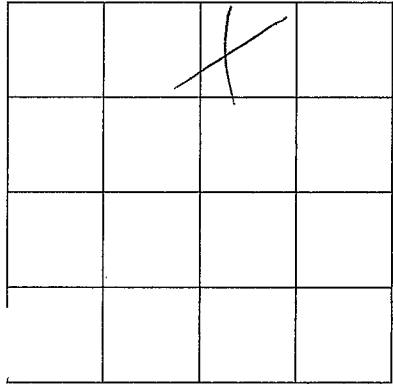

*2 screens
20 ft*

SECTION 2

Please indicate well location X.

ADDITIONAL INFORMATION

If more than one screen, show location of each on sketch.