

MISSISSIPPI DEPARTMENT OF NATURAL RESOURCES

Bureau of Land and Water Resources

Southport Mall

P.O. Box 10631

Jackson, Mississippi 39209

BUD PENNION & SONS
WATER WELL DRILLERS LOG

Water Well Service

Rt. 4, Box 402

Hammond, Mississippi 39426

Phone 601-798-5324

PRIVER
D 2020

9/29

1988

date well completed

Carrier, Mississippi 39426

Pearl River
county well located

LANDOWNER: William Lee

R-T-3 Box 13413

Lumberton Miss.
(mailing address)

description of formations encountered

from to

<u>red shale</u>	<u>0</u>	<u>15</u>
<u>red sand</u>	<u>15</u>	<u>70</u>
<u>grey shale</u>	<u>70</u>	<u>125</u>
<u>sand</u>	<u>125</u>	<u>195</u>

WELL LOCATION:

sec 31 T 1 N R 14 E
S W
6 miles NE of Joplin
(distance) (direction) (nearest town)

WELL PURPOSE: home
(home, irrigation, municipal, industrial)

WELL COMPLETION DATA:

- (1) diameter (inches) 4"
- (2) total depth (feet) 195-
- (3) static water level (feet) 22 below above top of ground.
- (4) casing PVC 180
(material) (depth)
(size) if telescope see back.
- (5) screen 15 180
(length) (depth to top)
12 PVC
(size) (material)
- (6) pump 1 1080
(HP) (yield gpm)
Elect
(type power)
- (7) electric log no
(yes or no)

(organization running log)

- (8) how well bottom plugged land
shale


DRILLERS REMARKS:

RECEIVED
NOV 15 1988

Department of Natural Resources
Bureau of Land & Water Resources

If well telescopes please sketch and show depths.

GROUND LEVEL

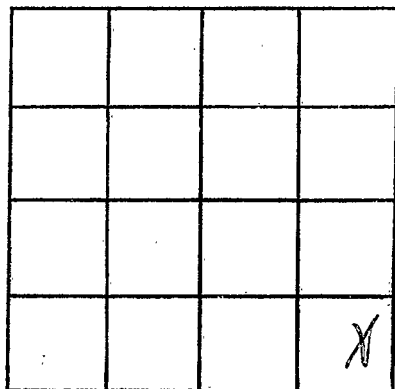

SECTION 31

Please indicate well location X.

ADDITIONAL INFORMATION

If more than one screen,
show locations of each on sketch.