

MISSISSIPPI DEPARTMENT OF NATURAL RESOURCES

Bureau of Land and Water Resources

P.O. Box 10631

Jackson, Mississippi 39209

WATER WELL DRILLERS LOG

COUNTY WELL LOCATED
PEARL RIVER

WELL NUMBER
D

2027

DATE WELL COMPLETED
12-15-88

PERMIT NUMBER
0-428

NAME OF DRILLING FIRM
WALKER'S WELL SERVICE

NAME & MAILING ADDRESS OF LANDOWNER
FRED MARTIN

LOT # 7 LAKEHORE

RR. HILLSDALE

WELL LOCATION: SEC **43** TOWNSHIP **1** RANGE **N 14 E**

DISTANCE **70** Miles **N** of **PICAYUNE**

OTHER LANDMARK

WELL PURPOSE Home Irrigation, Municipal, Industrial, Fish Pond, etc.

PUMP DATA

PUMP TYPE (Circle One):
Submersible, Turbine, **Jet** Flowing Well,
Other (Describe) _____

POWER TYPE (Circle One):
 Electric, Tractor, Diesel, Gasoline, Butane,
Other (Describe) _____

Pump Capacity (GPM)	No. of Stages	Setting Depth
12	2	60 FT.

PUMP TEST

Well yielded _____ GPM with
a drawdown of _____ ft.
after _____ hours of pumping

WELL DATA

Well Depth 114	Casing Diameter (In.) 2"	Casing Length (Ft.) 114
Type of Casing PVC	Hole Depth 115	Depth to Static Water Level 30

TYPE OF COMPLETION: (Circle One or More):
 Gravel Packed, Underreamed, Telescoped,
 Natural Development, Open Hole, Other
(Describe) **ASR**

Top of Lap Pipe or Reduction in Casing

FEET IF TELESCOPED OR MORE THAN ONE SCREEN: USE BACK PAGE.

LOG DATA

TYPE OF LOG RUN (Circle One):
No Log Run, Electric, Gamma Ray, Density, Sonic, Neutron,
Other (Describe) _____

Name of Organization Running Log

SCREEN DATA

Diameter - Inches 2	Length - Feet #10	Slot Size - Inches #10
Screen Type SCOT	Depth to Bottom - Feet 114'	

GEOLOGIC DATA (Office Use Only)

Surface Elev.	Geologic Unit	Unit Thickness	Depth to Top
Subs. SWL	Date	Analysis	Aquifer Test


Driller's Remarks

DESCRIPTION OF FORMATIONS ENCOUNTERED	FROM	TO
CLAY	0	15
SAND	15	20
CLAY	20	35
SAND	35	114

FORMATIONS (Continued)	FROM	TO
RECEIVED		
FEB 0 1989		
Department of Natural Resources Bureau of Land & Water Resources		
IF MORE SPACE IS NEEDED, USE BACK		

If well telescopes please sketch and show depths.

GROUND LEVEL

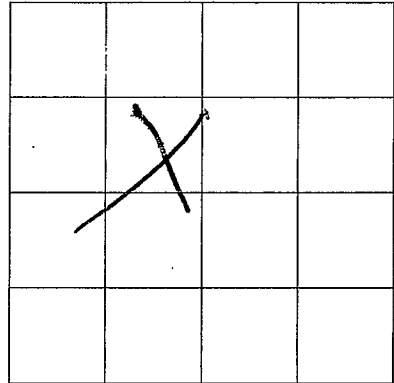

SECTION _____

Please indicate well location X.

ADDITIONAL INFORMATION

If more than one screen,
show location of each on sketch.