

MISSISSIPPI DEPARTMENT OF ENVIRONMENTAL QUALITY  
Bureau of Land and Water Resources

P. O. Box 10631  
Jackson, MS 39289-0631  
WATER WELL DRILLERS LOG

COUNTY WELL LOCATED  
**Pearl River**

WELL NUMBER **D** CODED

**2040**

DATE WELL COMPLETED  
**7-23-92**

PERMIT NUMBER

NAME OF DRILLING FIRM  
**Boone's Water Well**

NAME & MAILING ADDRESS OF LANDOWNER  
**Claude Walters**

**2187 Hwy 13**

**L7on, MS 39455**

WELL LOCATION: SEC TOWNSHIP RANGE  
**3 1 N 14 W**

DISTANCE DIRECTION NEAREST TOWN  
**5 Miles E of Lumberton**

OTHER LANDMARK

WELL PURPOSE:  Home Irrigation, Municipal, Industrial, Fish Pond, etc.

PUMP DATA

PUMP TYPE (Circle One):  
 Submersible, Turbine, Jet, Flowing Well,  
Other (Describe) \_\_\_\_\_

POWER TYPE (Circle One):  
 Electric, Tractor, Diesel, Gasoline, Butane,  
Other (Describe) \_\_\_\_\_ H/P **1**

Pump Capacity (GPM) No. of Stages Setting Depth  
**20** **50** FT.

PUMP TEST

Well yielded \_\_\_\_\_ GPM with  
a drawdown of \_\_\_\_\_ ft.  
after \_\_\_\_\_ hours of pumping

WELL DATA

Well Depth <b>90ft</b>	Casing Diameter (In.) <b>4</b>	Casing Length (Ft.) <b>70</b>
Type of Casing Sch <b>40</b>	Hole Depth <b>90</b>	Depth to Static Water Level

TYPE OF COMPLETION: (Circle One or More):  
 Gravel Packed, Underreamed, Telescoped,  
Natural Development, Open Hole, Other

Top of Lap Pipe or Reduction in Casing

FEET IF TELESCOPED OR MORE THAN ONE SCREEN: USE BACK PAGE

LOG DATA

TYPE OF LOG RUN (Circle One): No Log Run, Electric, Gamma Ray, Density, Sonic, Neutron, Other (Describe) \_\_\_\_\_

Name of Organization Running Log

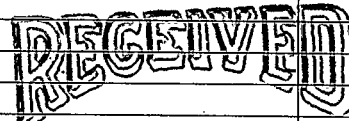
SCREEN DATA

Diameter - Inches <b>4</b>	Length - Feet <b>20</b>	Slot Size - Inches <b>#10</b>
Screen Type <b>Sch 40</b>	Depth to Bottom - Feet	

GEOLOGIC DATA (Office Use Only)

Surface Elev.	Geologic Unit	Unit Thickness	Depth to Top
Subs. SWL	Date	Analysis	Aquifer Test

Driller's Remarks

DESCRIPTION OF FORMATIONS ENCOUNTERED	FROM	TO	FORMATIONS (Continued)	FROM	TO
Clay	0	15	 <b>SEP 10 1992</b> Dept. of Environmental Quality Bureau of Land & Water Resources		
sand	15	90			

IF MORE SPACE IS NEEDED, USE BACK

If well telescopes please  
sketch and show depths.

GROUND LEVEL


SECTION \_\_\_\_\_

Please indicate well location X.

ADDITIONAL INFORMATION

If more than one screen,  
show location of each on sketch.