

MISSISSIPPI DEPARTMENT OF NATURAL RESOURCES

Bureau of Land and Water Resources

Southport Mall

P.O. Box 10631

Jackson, Mississippi 39209

WATER WELL DRILLERS LOG

P. River
D 2041

10-22 1992 Bud Penton Water Well Pearl River
 date well completed firm name county well located

LANDOWNER: Anthony Lund
 60 Thomas School
 Rd Lumberton MS 39455
 (mailing address)

description of formations encountered	from	to
	red clay	0
red sand	40	100

WELL LOCATION:

sec. 29 T. 1 N R. 14 E
 S W
 1 miles N of Gumpond
 (distance) (direction) (nearest town)

WELL PURPOSE:

(home, irrigation, municipal, industrial)


WELL COMPLETION DATA:

- (1) diameter (inches) 5
- (2) total depth (feet) 100
- (3) static water level (feet) 63 below top of ground.
- (4) casing PVC 90
 (material) (depth)
 2 (size) if telescope see back.
- (5) screen 10 90
 (length) (depth to top)
 2 PVC
 (size) (material)
- (6) pump NA NA
 (HP) (yield gpm)
 NA
 (type power)
- (7) electric log NO
 (yes or no)

(organization running log)

- (8) how well bottom plugged sandshark

DRILLERS REMARKS:

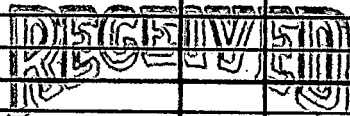


DEC 10 1992

Dept. of Environmental Quality
 Bureau of Land & Water Resources

If well telescopes please sketch and show depths.

GROUND LEVEL

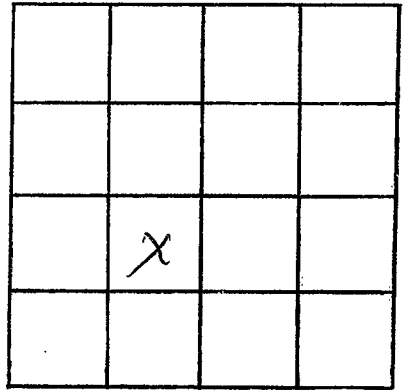

SECTION 29

Please indicate well location X.

ADDITIONAL INFORMATION

If more than one screen,
show locations of each on sketch.