

MISSISSIPPI DEPARTMENT OF NATURAL RESOURCES

Bureau of Land and Water Resources

Southport Mall

P.O. Box 10631

Jackson, Mississippi 39209

WATER WELL DRILLERS LOG

L. RIVER
D 2043

8-8 19 92 Bud Penton Water Well Pearl River
date well completed firm name county well located

LANDOWNER: Gordon Colery
Gumpond Rd Poplarville
M LA
(mailing address)

| description of formations encountered | from | to |
|---------------------------------------|------|----|
| red shale | 0 | 12 |
| red sand | 12 | 85 |

WELL LOCATION:
sec. 33 T 1 N R 14 E
S W
1 miles East of Gumpond
(distance) (direction) (nearest town)

WELL PURPOSE: Home
(home, irrigation, municipal, industrial)

WELL COMPLETION DATA:

(1) diameter (inches) 7

(2) total depth (feet) 85

(3) static water level (feet) 60 below above top of ground.


(4) casing PVC 85'
(material) (depth)
4" if telescope see back.
(size)

(5) screen 10' 85'
(length) (depth to top)
4" PVC
(size) (material)

(6) pump 2 20
(HP) (yield gpm)
electric
(type power)

(7) electric log NO
(yes or no)
(organization running log)

(8) how well bottom plugged sandshark

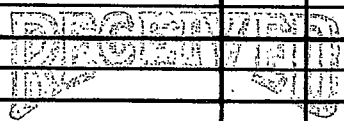


APR 23 1993

Dept. of Natural Resources
Office of Land & Water Management

DRILLERS REMARKS:

If well telescopes please sketch and show depths.

GROUND LEVEL

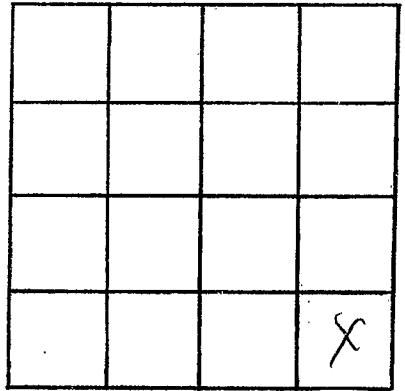

SECTION 33

Please indicate well location X.

ADDITIONAL INFORMATION

If more than one screen, show locations of each on sketch.