

MISSISSIPPI DEPARTMENT OF ENVIRONMENTAL QUALITY
Bureau of Land and Water Resources

P. O. Box 10631
Jackson, MS 39289-0631
WATER WELL DRILLERS LOG

COUNTY WELL LOCATED
PEARL RIVER

WELL NUMBER **D 2049** CODBD

DATE WELL COMPLETED
3-4-93

PERMIT NUMBER

NAME OF DRILLING FIRM
BOONES WATER WELL

NAME & MAILING ADDRESS OF LANDOWNER
L. H. LADNER
Gumpond Rd
L'Lon, MS 39455

WELL LOCATION: SEC _____ TOWNSHIP _____ RANGE _____
20 1 S 14 W

DISTANCE _____ DIRECTION _____ NEAREST TOWN _____
7 Miles SE of Lumberton

OTHER LANDMARK

WELL PURPOSE Home, Irrigation, Municipal, Industrial, Fish Pond, etc.

PUMP DATA

PUMP TYPE (Circle One):
Submersible, Turbine, Jet, Flowing Well,
Other (Describe) _____

POWER TYPE (Circle One):
Electric, Tractor, Diesel, Gasoline, Butane,
Other (Describe) _____ H/P _____

Pump Capacity (GPM) _____ No. of Stages _____ Setting Depth _____ FT.

PUMP TEST

Well yielded _____ GPM with
a drawdown of _____ ft.
after _____ hours of pumping

WELL DATA

Well Depth 80	Casing Diameter (In.) 4	Casing Length (Ft.) 70
Type of Casing sch 40	Hole Depth 80	Depth to Static Water Level

TYPE OF COMPLETION: (Circle One or More):
Gravel Packed, Underreamed, Telescoped,
Natural Development, Open Hole, Other _____

Top of Lap Pipe or Reduction in Casing _____ FEET

IF TELESCOPED OR MORE THAN ONE SCREEN: USE BACK PAGE

LOG DATA

TYPE OF LOG RUN (Circle One): No Log Run, Electric, Gamma Ray, Density, Sonic, Neutron, Other (Describe) _____

Name of Organization Running Log _____

SCREEN DATA

Diameter - Inches 4	Length - Feet 10	Slot Size - Inches
Screen Type sch 40	Depth to Bottom - Feet 80	

GEOLOGIC DATA (Office Use Only)

Surface Elev.	Geologic Unit	Unit Thickness	Depth to Top
Subs. SWL	Date	Analysis	Aquifer Test


Driller's Remarks

DESCRIPTION OF FORMATIONS ENCOUNTERED	FROM	TO
CLAY	0	30
SAND	30	80

FORMATIONS (Continued)	FROM	TO
RECEIVED		
MAY 07 1993		
Dept. of Environmental Quality Office of Land & Water Resources		
IF MORE SPACE IS NEEDED, USE BACK		

If well telescopes please
sketch and show depths.

GROUND LEVEL

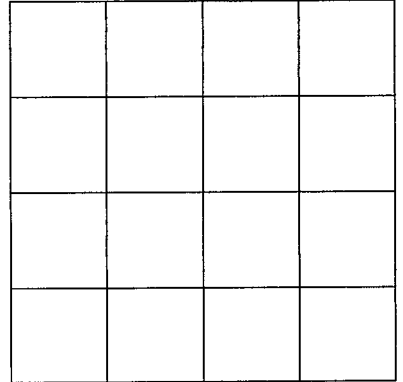

SECTION _____

Please indicate well location X.

ADDITIONAL INFORMATION

If more than one screen,
show location of each on sketch.
