

MISSISSIPPI DEPARTMENT OF NATURAL RESOURCES

Bureau of Land and Water Resources

P.O. Box 10631

Jackson, Mississippi 39209

WATER WELL DRILLERS LOG

COUNTY WELL LOCATED Pearl River	
WELL NUMBER D 2065	CODED
DATE WELL COMPLETED 6-5-98	

PERMIT NUMBER
NAME OF DRILLING FIRM Griner Drilling Service, Inc.

NAME & MAILING ADDRESS OF LANDOWNER Brighton Energy			
1500 Thompson Blvd, 20 East Fifth			
Tulsa, OK 74103			
WELL LOCATION:	SEC	TOWNSHIP	RANGE
	15	1	14
DISTANCE	DIRECTION	NEAREST TOWN	
4 Miles	S	Lumberton	
OTHER LANDMARK			
WELL PURPOSE: Home, Irrigation, Municipal, Industrial, Fish Pond, etc. Oilfield Supply Well			

PUMP DATA		
PUMP TYPE (Circle One): Submersible Turbine, Jet, Flowing Well, Other (Describe)		
POWER TYPE (Circle One): Electric , Tractor, Diesel, Gasoline, Butane, Other (Describe)		
Pump Capacity (GPM) 80	No. of Stages 13	Setting Depth 200 FT.
PUMP TEST		
Well yielded 60 GPM with a drawdown of _____ ft. after _____ hours of pumping		

WELL DATA		
Well Depth 420	Casing Diameter (In.) 4	Casing Length (Ft.) 390 390
Type of Casing PVC	Hole Depth 420	Depth to Static Water Level 50'
TYPE OF COMPLETION: (Circle One or More): Gravel Packed , Underreamed, Telescoped, Natural Development, Open Hole, Other (Describe)		
Top of Lap Pipe or Reduction in Casing FEET IF TELESCOPED OR MORE THAN ONE SCREEN: USE BACK PAGE		

LOG DATA	
TYPE OF LOG RUN (Circle One): No Log Run , Electric, Gamma Ray, Density, Sonic, Neutron, Other (Describe)	
Name of Organization Running Log	

SCREEN DATA		
Diameter - Inches 4	Length - Feet 30	Slot Size - Inches .010
Screen Type PVC	Depth to Bottom - Feet 420	


GEOLOGIC DATA (Office Use Only)			
Surface Elev.	Geologic Unit	Unit Thickness	Depth to Top
Subs. SWL	Date	Analysis	Aquifer Test
Driller's Remarks			

DESCRIPTION OF FORMATIONS ENCOUNTERED	FROM	TO
Clay & Sand	0	200
Clay	200	205
Sand & Pea Gravel	205	420

FORMATIONS (Continued)	FROM	TO
RECEIVED		
JUN 10 1998		
Dept. of Environmental Quality Office of Land & Water Resources		
IF MORE SPACE IS NEEDED, USE BACK		

If well telescopes please
sketch and show depths.

GROUND LEVEL

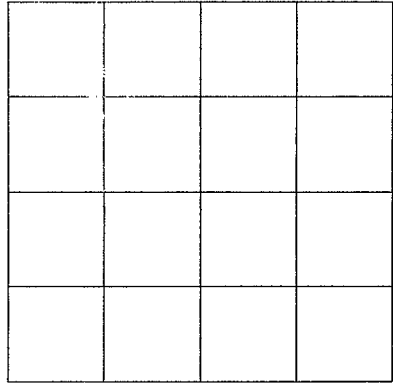

SECTION _____

Please indicate well location X.

ADDITIONAL INFORMATION

If more than one screen,
show location of each on sketch.