

**MISSISSIPPI DEPARTMENT OF ENVIRONMENTAL  
QUALITY**  
Office of Land and Water Resources

P. O. Box 10631  
Jackson, MS 39289-0631  
**WATER WELL DRILLERS LOG**

COUNTY WELL LOCATED <i>Pearl River</i>	
WELL NUMBER <i>D-2076</i>	CODED
DATE WELL COMPLETED <i>11-11-99</i>	

PERMIT NUMBER
NAME OF DRILLING FIRM <i>Boone's Water Well</i>

NAME & MAILING ADDRESS OF LANDOWNER <i>Joseph Ladner</i>			
<i>41 Otis Ladner Rd</i>			
<i>Lumberton, MS 39455</i>			
WELL LOCATION:	SEC <i>27</i>	TOWNSHIP <i>1</i>	RANGE <i>N 14 E</i>
DISTANCE <i>7</i> Miles	DIRECTION <i>SE</i>	NEAREST TOWN <i>Lumberton</i>	
OTHER LANDMARK			
WELL PURPOSE: <input checked="" type="checkbox"/> Home Irrigation, Municipal, Industrial, Fish Pond, etc.			

PUMP DATA		
PUMP TYPE (Circle One): Submersible, Turbine, Jet, Flowing Well, Other (Describe) _____		
POWER TYPE (Circle One): Electric, Tractor, Diesel, Gasoline, Butane, Other (Describe) _____ H/P _____		
Pump Capacity (GPM)	No. of Stages	Setting Depth  FT.
PUMP TEST		
Well yielded _____ GPM with a drawdown of _____ ft. after _____ hours of pumping		

WELL DATA		
Well Depth <i>100</i>	Casing Diameter (In.) <i>2</i>	Casing Length (Ft.) <i>90</i>
Type of Casing <i>Sch 40</i>	Hole Depth <i>100</i>	Depth to Static Water Level <i>60</i>

LOG DATA	
TYPE OF LOG RUN (Circle One): No Log Run, Electric, Gamma Ray, Density, Sonic, Neutron, Other (Describe) _____	
Name of Organization Running Log	

TYPE OF COMPLETION: (Circle One or More): <input checked="" type="checkbox"/> Gravel Packed, <input type="checkbox"/> Underreamed, <input type="checkbox"/> Telescoped, <input type="checkbox"/> Natural Development, <input type="checkbox"/> Open Hole, <input type="checkbox"/> Other			
(Describe) _____			

GEOLOGIC DATA (Office Use Only)			
Surface Elev.	Geologic Unit	Unit Thickness	Depth to Top
Subs. SWL	Date	Analysis	Aquifer Test

WELL GROUTED TO A DEPTH OF <i>10</i> FEET	
Type Grout (circle one): <input checked="" type="checkbox"/> Cement, <input type="checkbox"/> Bentonite, or Mix	

Driller's Remarks <i>Drill + Set Casing only</i>	
Top of Lap Pipe or Reduction in Casing FEET <input type="checkbox"/> IF TELESCOPED OR MORE THAN ONE SCREEN: USE BACK PAGE	

SCREEN DATA		
Diameter - Inches <i>2</i>	Length - Feet <i>10</i>	Slot Size - Inches <i>#8</i>
Screen Type <i>Sch 40</i>		Depth to Bottom - Feet

DESCRIPTION OF FORMATIONS ENCOUNTERED	FROM	TO	FORMATIONS (Continued)	
			FROM	TO
<i>Sand</i>	<i>0</i>	<i>30</i>		
<i>Clay</i>	<i>30</i>	<i>70</i>		
<i>Sand</i>	<i>70</i>	<i>100</i>		

**RECEIVED**

JUL 27 2000

Dept. of Environmental Quality  
Office of Land & Water Resources


IF MORE SPACE IS NEEDED, USE BACK

If well telescopes please  
sketch and show depths.

---

GROUND LEVEL

---

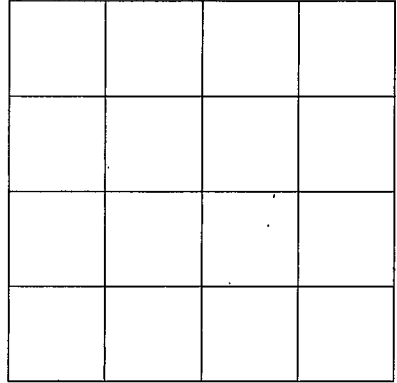

SECTION \_\_\_\_\_

Please indicate well location X.

---

ADDITIONAL INFORMATION

---

---

If more than one screen,  
show location of each on sketch.

---