

MISSISSIPPI DEPARTMENT OF ENVIRONMENTAL

QUALITY

Office of Land and Water Resources

P. O. Box 10631

Jackson, MS 39289-0631

WATER WELL DRILLERS LOG

COUNTY WELL LOCATED Pearl River	
WELL NUMBER D-2080	CODED
DATE WELL COMPLETED 1-4-00	

PERMIT NUMBER
NAME OF DRILLING FIRM Bobne's Water Well

NAME & MAILING ADDRESS OF LANDOWNER
Bennie Lachea

Thomas School Rd

Lumberton, ms 39455

WELL LOCATION: SEC **27** TOWNSHIP **1** RANGE **14**

DISTANCE **6** Miles DIRECTION **S** of NEAREST TOWN **Lumberton**

OTHER LANDMARK

WELL PURPOSE: Home Irrigation, Municipal, Industrial, Fish Pond, etc.

PUMP DATA

PUMP TYPE (Circle One):
Submersible, Turbine, Jet, Flowing Well,
Other (Describe) _____

POWER TYPE (Circle One):
Electric, Tractor, Diesel, Gasoline, Butane,
Other (Describe) _____ H/P **1**

Pump Capacity (GPM) **20** No. of Stages _____ Setting Depth _____ FT.

PUMP TEST

Well yielded _____ GPM with
a drawdown of _____ ft.
after _____ hours of pumping

WELL DATA

Well Depth 140	Casing Diameter (In.) 4	Casing Length (Ft.) 120
Type of Casing Sch 40	Hole Depth 140	Depth to Static Water Level 60

LOG DATA

TYPE OF LOG RUN (Circle One): No Log Run, Electric, Gamma Ray, Density, Sonic, Neutron,
Other (Describe) _____

Name of Organization Running Log

TYPE OF COMPLETION: (Circle One or More):
Gravel Packed, Underreamed, Telescoped,
Natural Development, Open Hole, Other

WELL GROUTED TO A DEPTH OF **10** FEET
Type Grout (circle one): Cement, Bentonite, or Mix

GEOLOGIC DATA (Office Use Only)

Surface Elev.	Geologic Unit	Unit Thickness	Depth to Top
Subs. SWL ?	Date	Analysis	Aquifer Test

SCREEN DATA

Diameter - Inches 4	Length - Feet 20	Slot Size - Inches #8
Screen Type Sch 40	Depth to Bottom - Feet	

Driller's Remarks

Top of Lap Pipe or Reduction in Casing

FEET IF TELESCOPED OR MORE THAN ONE SCREEN: USE BACK PAGE

DESCRIPTION OF FORMATIONS ENCOUNTERED	FROM	TO	FORMATIONS (Continued)	FROM	TO
Clay	0	20			
Sand	20	140			


RECEIVED
JUL 27 2000

Dept. of Environmental Quality
Office of Land & Water Resources

IF MORE SPACE IS NEEDED, USE BACK

If well telescopes please
sketch and show depths.

GROUND LEVEL

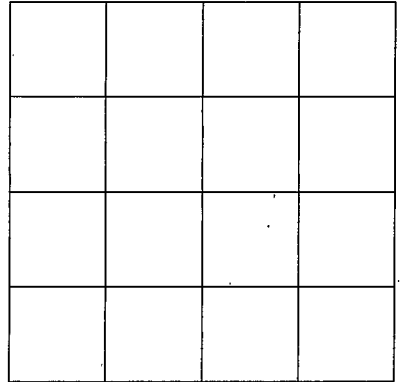

SECTION _____

Please indicate well location X.

ADDITIONAL INFORMATION

If more than one screen,
show location of each on sketch.