

MISSISSIPPI DEPARTMENT OF ENVIRONMENTAL QUALITY
Office of Land and Water Resources

P. O. Box 10631
Jackson, MS 39289-0631
WATER WELL DRILLERS LOG

COUNTY WELL LOCATED Pearl River	
WELL NUMBER D-2099	CODED
DATE WELL COMPLETED 10-27-00	

PERMIT NUMBER
NAME OF DRILLING FIRM Boone's Water Well

NAME & MAILING ADDRESS OF LANDOWNER Bob Close		
10 Elmer Smith Rd		
Lumberton, MS 39455		
WELL LOCATION:	SEC	TOWNSHIP
	33	1 N 14 E
DISTANCE	DIRECTION	NEAREST TOWN
4 Miles	E	Hillsdale
OTHER LANDMARK		
WELL PURPOSE <input checked="" type="checkbox"/> Irrigation, Municipal, Industrial, Fish Pond, etc.		

PUMP DATA		
PUMP TYPE (Circle One): Submersible, Turbine, <input checked="" type="checkbox"/> Jet, Flowing Well, Other (Describe) _____		
POWER TYPE (Circle One): <input checked="" type="checkbox"/> Electric, Tractor, Diesel, Gasoline, Butane, Other (Describe) _____ H/P 1		
Pump Capacity (GPM) 5	No. of Stages 2	Setting Depth FT.
PUMP TEST		
Well yielded _____ GPM with a drawdown of _____ ft. after _____ hours of pumping		

WELL DATA

Well Depth 110	Casing Diameter (In.) 2	Casing Length (Ft.) 100
Type of Casing Sch 40	Hole Depth 110	Depth to Static Water Level 45

TYPE OF COMPLETION: (Circle One or More):
 Gravel Packed, Underreamed, Telescoped,
 Natural Development, Open Hole, Other
 (Describe) _____

WELL GROUTED TO A DEPTH OF **10** FEET
 Type Grout (circle one): Cement, Bentonite, or Mix

SCREEN DATA

Diameter - Inches 2	Length - Feet 10	Slot Size - Inches #8
Screen Type Sch 40	Depth to Bottom - Feet	

LOG DATA

TYPE OF LOG RUN (Circle One): No Log Run, Electric, Gamma Ray, Density, Sonic, Neutron, Other (Describe) _____	
Name of Organization Running Log	

GEOLOGIC DATA (Office Use Only)

Surface Elev.	Geologic Unit	Unit Thickness	Depth to Top
Subs. SWL	Date	Analysis	Aquifer Test

Driller's Remarks	
Top of Lap Pipe or Reduction in Casing	
FEET	IF TELESCOPED OR MORE THAN ONE SCREEN: USE BACK PAGE


DESCRIPTION OF FORMATIONS ENCOUNTERED	FROM	TO
Clay	0	40
Sand	40	110

FORMATIONS (Continued)	FROM	TO

REC'D AUG 24 2001

If well telescopes please
sketch and show depths.

GROUND LEVEL

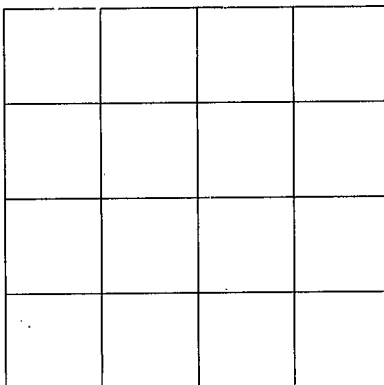

SECTION _____

Please indicate well location X.

ADDITIONAL INFORMATION

If more than one screen,
show location of each on sketch.