

PEARL RIVER
E1
5-6-71

MISSISSIPPI
BOARD OF WATER COMMISSIONERS
416 North State Street
Jackson, Mississippi 39201

CODED

WATER WELL DRILLERS LOG

May 6 1971 Harold Woodward Pearl River
date well completed firm name county well located

LANDOWNER: Devon Thomas
Pt. 3
Poplarville, Miss.
(mailing address)

WELL LOCATION:
sec. 34 T 2 N R 12 E
S W
20 miles of Poplarville
(distance) (direction) (nearest town)

WELL PURPOSE: Home
(home, irrigation, municipal, industrial)

- WELL COMPLETION DATA:
- (1) diameter (inches) 2"
 - (2) total depth (feet) 105
 - (3) static water level (feet) 40 below above top of ground.
 - (4) casing plastic 100 (material) (depth)
2" (size) if telescope see back.
 - (5) screen 5' 100' (length) (depth to top)
2" (size) plastic (material)
 - (6) pump 1/2 628 (HP) (yield gpm)
115V (type power)
 - (7) electric log no (yes or no)
S&P (organization running log)
 - (8) how well bottom plugged

description of formations encountered	from	to
Red clay	0	18
Brown	18	30
blue clay	30	80
fine sand	80	85
chrome sand	85	105'

CODED


JUN 23 1971

MISS. BD. OF
WATER COMM.

DRILLERS REMARKS:

If well telescopes please sketch and show depths.

GROUND LEVEL

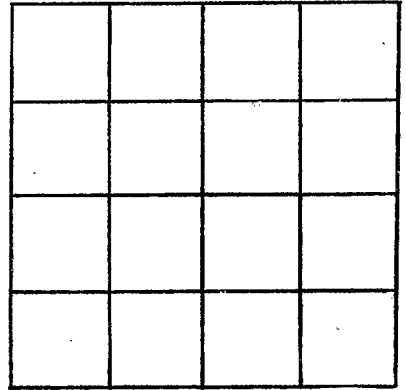

SECTION _____

Please indicate well location X.

ADDITIONAL INFORMATION

If more than one screen,
show locations of each on sketch.