

Pearl R.

E-2

10-22-60

WATER WELL DRILLERS LOG

F-300

Date 10-22, 1960, Driller: Dick & Eric Baughman (Name) County Polk

CODED

(1) Owner of Land: Orvil Baughman
 (Name)
Lebensville R.F.D.
 (Address)

(2) Location: 1/4, 1/4, Sec. 31 T2 R7
2 miles North Becks Branch
 (distance) (direction) (Nearest Town)

(3) Topography: X (Hilly) (Flat) (Level)

(4) Purpose of Well: Domestic
 (Domestic Irrigation, Municipal, Industrial, Other)

Description & Color of Materials Sand, Clay, Red Clay, Shell, etc.	Thick- ness Feet	Depth Feet
<u>White Red sand</u>	<u>0</u>	<u>110</u>
<u>White Blue Clay</u>	<u>110</u>	<u>250</u>
<u>Good grey sub.</u>	<u>250</u>	<u>278</u>

Information upon completion of well:

(1) Diameter 2 inches.

(2) Total Depth 278 feet.

(3) Water Level 30 feet below top of ground.

(4) Cased to _____, Size _____

(5) Screen: Size 2", Length 5'


(6) Were any formations sealed against pollution?
 _____ yes, _____ X no.

CODED

If YES depth of formation _____

Why _____

Drillers Remarks: Good well

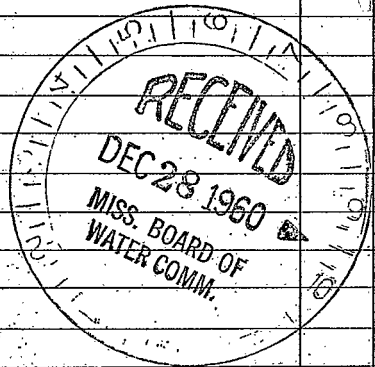

28

(Use Back Side)

Well No.

