

PEARL RIVER

E 6

1-7-71

MISSISSIPPI BOARD OF WATER COMMISSIONERS
416 North State Street
Jackson, Mississippi 39201

CODED

WATER WELL DRILLERS LOG

1-7 1971 *Mc Lewis Water Well Dr* Pearl River
date well completed firm name county well located

LANDOWNER: *Maggie Seale*

Rt #1 *Papleville, Miss*

(mailing address)

description of formations encountered

from

to

<i>clay</i>	0	20
<i>sand</i>	20	60
<i>clay</i>	60	185
<i>sand</i>	185	231

WELL LOCATION:

sec. *17* T. *2* N. R. *18* E
S W
3 3/4 miles *NE* *Cross Road*
(distance) (direction) (nearest town)

WELL PURPOSE: *home*
(home, irrigation, municipal, industrial)

WELL COMPLETION DATA:

- (1) diameter (inches) *2*
- (2) total depth (feet) *231*
- (3) static water level (feet) *10* below above top of ground.
- (4) casing *steel* *147*
(material) (depth)

(size) if telescope see back.

- (5) screen *None*
(length) (depth to top)

Open End
(size) (material)

- (6) pump *1/2* *60*
(HP) (yield gpm)
Electric
(type power)

- (7) electric log *No*
(yes or no)

(organization running log)

- (8) has well bottom plugged *open*
End

DRILLERS REMARKS:


CODED

NOV 15 1971

MISS. BD. OF
WATER COMM.

If well telescopes please sketch and show depths.

GROUND LEVEL

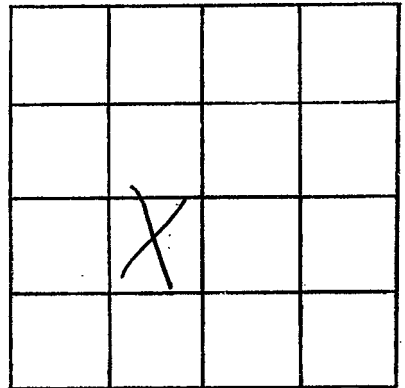

SECTION

07

Please indicate well location X.

ADDITIONAL INFORMATION

If more than one screen, show locations of each on sketch.