

P.R.  
E7  
7/2/79  
F-2

MISSISSIPPI  
BOARD OF WATER COMMISSIONERS  
416 North State Street  
Jackson, Mississippi 39201 **CODED**

WATER WELL DRILLERS LOG

1974 Paul Venters & Son Pearl River  
date well completed firm name county well located

LANDOWNER:

Wilton Beidenham  
Poplarville, Miss.  
(mailing address)

description of formations encountered

Red Shale  
Red Sand

from	to
<u>0</u>	<u>61</u>
<u>61</u>	<u>112</u>

WELL LOCATION:

sec. 4 T. 2 N. R. 18 E.  
15 miles E of Poplarville  
(distance) (direction) (nearest town)

WELL PURPOSE: Home  
(home, irrigation, municipal, industrial)

**CODED**


WELL COMPLETION DATA:

- (1) diameter (inches) 4 in
- (2) total depth (feet) 112
- (3) static water level (feet) 71 below above top of ground.
- (4) casing PVC 102  
(material) (depth)  
1/2 if telescope see back.  
(size)
- (5) screen 4x10 102  
(length) (depth to top)  
4x10 PVC 1012  
(size) (material)
- (6) pump 1/2 650  
(HP) (yield gpm)  
electric  
(type power)
- (7) electric log NO  
(yes or no)

(organization running log)

(8) how well bottom plugged  
Small Shale

DRILLERS REMARKS:

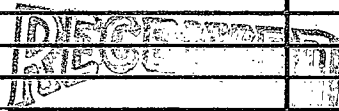


OCT - 9 1974

MISS. BD. OF WATER COMMISSIONERS

If well telescopes please sketch and show depths.

GROUND LEVEL

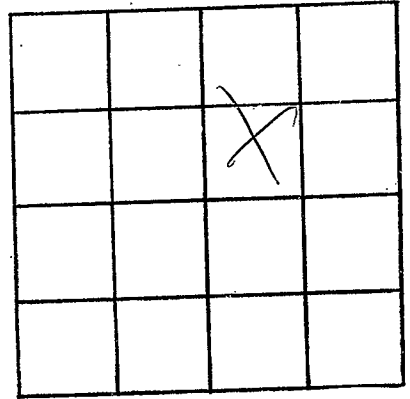

SECTION \_\_\_\_\_

Please indicate well location X.

ADDITIONAL INFORMATION

If more than one screen, show locations of each on sketch.