

Pearl River
 E 8
 6-69

MISSISSIPPI
 BOARD OF WATER COMMISSIONERS
 416 North State Street
 Jackson, Mississippi 39201

CODED

WATER WELL DRILLERS LOG

6-13 1969 HORACE A. POOLE PEARL RIVER
 date well completed firm name county well located


LANDOWNER: <u>V. Spence</u>	description of formations encountered	from	to
<u>RT#1</u>	<u>SURFACE CLAY</u>	<u>0</u>	<u>10</u>
<u>POPLARVILLE MISS</u> (mailing address)	<u>SAND & PEA GRAVEL</u> <u>CLAY</u> <u>SAND</u>	<u>10</u> <u>20</u> <u>24</u>	<u>20</u> <u>24</u> <u>32</u>
WELL LOCATION: sec. <u>6 T 2 N</u> <u>R 17 E</u> <u>8</u> miles <u>West</u> of <u>POPLARVILLE</u> (distance) (direction) (nearest town)			
WELL PURPOSE: <u>HOME</u> (home, irrigation, municipal, industrial)			
WELL COMPLETION DATA: (1) diameter (inches) <u>4</u> (2) total depth (feet) <u>32</u> (3) static water level (feet) <u>10'</u> below top of ground. (4) casing <u>PVC</u> , <u>27'</u> (material) (depth) <u>2"</u> if telescope see back. (size) (5) screen <u>5'</u> , <u>27'</u> (length) (depth to top) <u>2" O.12</u> , <u>PVC</u> (size) (material) (6) pump <u>1/2</u> <u>3</u> (HP) (yield gpm) <u>3.5</u> (type power) (7) electric log <u>no</u> (yes or no) (organization running log) (8) how well bottom plugged _____			
DRILLERS REMARKS:			

JUN 14 1969

MISS. DIV. OF WATER CONTROL

If well telescopes please sketch and show depths.

GROUND LEVEL

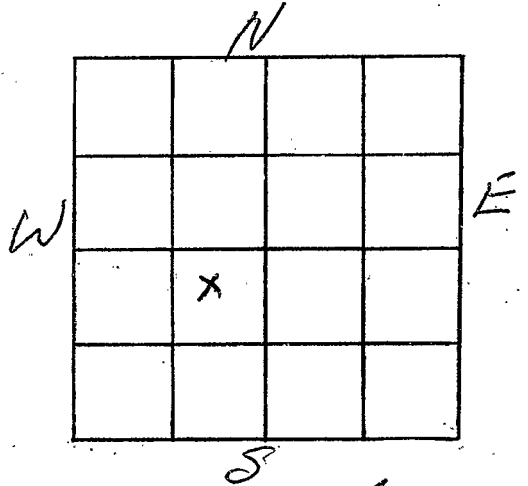

SECTION 6

Please indicate well location X.

ADDITIONAL INFORMATION

If more than one screen,
show locations of each on sketch.