

MISSISSIPPI  
BOARD OF WATER COMMISSIONERS  
416 North State Street  
Jackson, Mississippi 39201

WATER WELL DRILLERS LOG

PEARL RIVER  
E9  
7-15-69

7-15 1969 Mc Sherr's Water Well Pearl River  
date well completed firm name county well located

LANDOWNER: Joe Humphrey  
Cross Road, Miss  
(mailing address)

description of formations encountered	from	to
<u>Clay</u>	<u>0</u>	<u>30</u>
<u>fine sand</u>	<u>30</u>	<u>60</u>
<u>course sand</u>	<u>60</u>	<u>80</u>
<u>shale</u>	<u>80</u>	<u>85</u>

WELL LOCATION:  
sec. 31 T. 2 N. R. 17 W  
4 miles NE of Cross Road  
(distance) (direction) (nearest town)

WELL PURPOSE: Home  
(home, irrigation, municipal, industrial)

WELL COMPLETION DATA:

(1) diameter (inches) 2"

(2) total depth (feet) 85'

(3) static water level (feet) 35' below above top of ground.

(4) casing Galv. 85'  
(material) (depth)  
(size) if telescope see back.

(5) screen 5' 80  
(length) (depth to top)  
2 Stainless  
(size) (material)

(6) pump 3/4 560  
(HP) (yield gpm)  
Electric  
(type power)

(7) electric log No  
(yes or no)

(organization running log)


(8) how well bottom plugged Back  
Pressure Valve

DRILLERS REMARKS:

AUG 15 1969  
MISS. BUREAU OF WATER RESOURCES

If well telescopes please sketch and show depths.

GROUND LEVEL

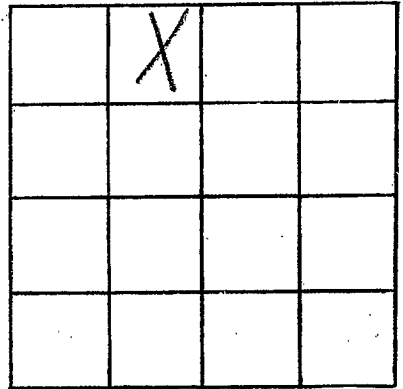

SECTION 31

Please indicate well location X.

ADDITIONAL INFORMATION

If more than one screen,  
show locations of each on sketch.