

Pearl River
E 10
7-16-69

MISSISSIPPI  
BOARD OF WATER COMMISSIONERS  
416 North State Street  
Jackson, Mississippi 39201

WATER WELL DRILLERS LOG

7-16 1969 Mc Shea Water Well Pearl River  
date well completed firm name county well located

LANDOWNER: Joe Humphrey  
Cross Road, Miss

description of formations encountered

from to

<u>Clay</u>	<u>0</u>	<u>35</u>
<u>fine sand</u>	<u>35</u>	<u>45</u>
<u>coarse sand</u>	<u>45</u>	<u>60</u>

(mailing address)

WELL LOCATION:

sec. 31 T. 2 N R. 17 E  
S W  
4 miles NE of Cross Road  
(distance) (direction) (nearest town)

WELL PURPOSE: Home  
(home, irrigation, municipal, industrial)

WELL COMPLETION DATA:

- (1) diameter (inches) 2
- (2) total depth (feet) 60
- (3) static water level (feet) 40 below above top of ground.
- (4) casing PVC, 60  
(material) (depth)  
(size) if telescope see back.
- (5) screen 5', 55'  
(length) (depth to top)  
2", PVC  
(size) (material)
- (6) pump 3/4, 400  
(HP) (yield gpm)  
Electric  
(type power)
- (7) electric log NO  
(yes or no)

(organization running log)

(8) how well bottom plugged Panel Pressure Valve


DRILLERS REMARKS:

AUG 15 1969

MISS. BD. OF  
WATER COMMISSIONERS

If well telescopes please sketch and show depths.

GROUND LEVEL

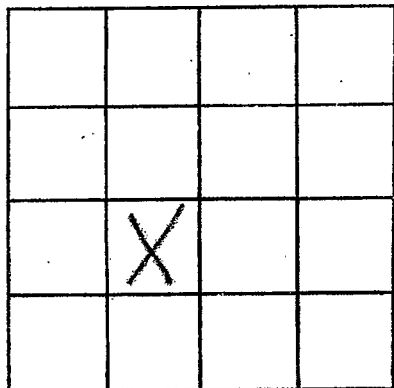

SECTION

31

Please indicate well location X.

ADDITIONAL INFORMATION

If more than one screen,  
show locations of each on sketch.