

Paul River
E 11
12-18-69

MISSISSIPPI
 BOARD OF WATER COMMISSIONERS
 416 North State Street
 Jackson, Mississippi 39201

CODED

CODED

WATER WELL DRILLERS LOG

date well completed Dec. 18 1969 firm name HAROLD Woodward county well located Paul River


| LANDOWNER: | description of formations encountered | from | to |
|---|---------------------------------------|------------|------------|
| <u>Wt. 3</u> | <u>Red Clay</u> | <u>2</u> | <u>20</u> |
| <u>Poplarville</u> (mailing address) | <u>find Red sand</u> | <u>23</u> | <u>35</u> |
| WELL LOCATION: sec. <u>25</u> T <u>2</u> N R <u>17</u> E <u>8</u> miles <u>W</u> of <u>Poplarville</u> (distance) (direction) (nearest town) | <u>purple clay</u> | <u>33</u> | <u>55</u> |
| WELL PURPOSE: (home, irrigation, municipal, industrial) | <u>find white sand</u> | <u>55</u> | <u>75</u> |
| WELL COMPLETION DATA: (1) diameter (inches) <u>4"</u> | <u>sand very few</u> | | |
| (2) total depth (feet) <u>118'</u> | <u>Rock</u> | <u>75</u> | <u>118</u> |
| (3) static water level (feet) <u>33</u> below top of ground. | <u>blue clay</u> | <u>118</u> | |
| (4) casing <u>plastic</u> (material) <u>100</u> (depth) | | | |
| (size) _____ if telescope see back. | | | |
| (5) screen <u>10'</u> (length) <u>100 ft</u> (depth to top) | | | |
| (size) _____ (material) | | | |
| (6) pump <u>2</u> (HP) <u>900</u> (yield gpm) | | | |
| <u>115 PC</u> (type power) | | | |
| (7) electric log <u>8</u> (yes or no) | | | |
| (organization running log) | | | |
| (8) how well bottom plugged <u>2" SS</u> | | | |

DRILLERS REMARKS:

JAN 24 1970
 MISS. BD. OF
 WATER COM.

If well telescopes please
sketch and show depths.

GROUND LEVEL

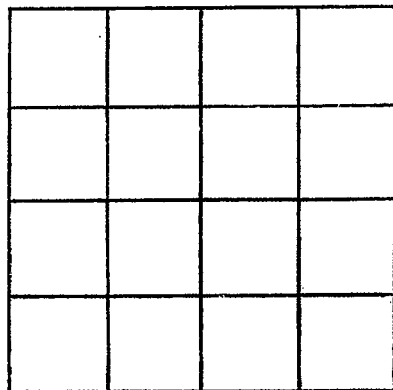

SECTION _____

Please indicate well location X.

ADDITIONAL INFORMATION

If more than one screen,
show locations of each on sketch.