

Pearl River
E 12
12-19-69

MISSISSIPPI
BOARD OF WATER COMMISSIONERS
416 North State Street
Jackson, Mississippi 39201

CODED

CODED

WATER WELL DRILLERS LOG

Dec. 19 1969 Harold Woodward Pearl River
date well completed firm name county well located
BOYAL USA, LA.

LANDOWNER:	description of formations encountered	from	to
Morgan			
See p. -			
1113 Poplarville, Miss (mailing address)	Red clay Red clay	0	8
WELL LOCATION:	white clay	8	20
sec. 35 T. 2 N R. 17 E X S X W	blue clay	20	35
(distance) miles (direction) of (nearest town)	gravel clay	35	70
WELL PURPOSE: Home (home, irrigation, municipal, industrial)	find blue sand	70	80
WELL COMPLETION DATA:	Change blue sand + gravel sand	85	107
(1) diameter (inches) 2"			
(2) total depth (feet) 106'			
(3) static water level (feet) _____ below top of ground. above			
(4) casing <u>plastic</u> 101' (material) (depth)			
(size) If telescope see back.			
(5) screen 5' 101' (length) (depth to top)			
2" plastic (size) (material)			
(6) pump 3/4 460 (HP) (yield gpm)			
115 AC (type power)			
(7) electric log <u>no</u> (yes or no)			
(organization running log)			
(8) how well bottom plugged 2" SS B.W. Hank			


set at 106 ft

JAN 14 1970
MISS. DIV. OF WATER

DRILLERS REMARKS:

If well telescopes please sketch and show depths.

GROUND LEVEL

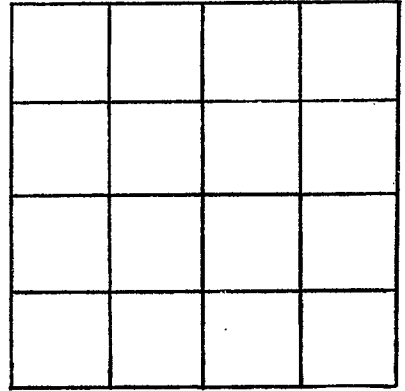

SECTION _____

Please indicate well location X.

ADDITIONAL INFORMATION

If more than one screen,
show locations of each on sketch.