

Pearl River
E 13
11-21-69

MISSISSIPPI
BOARD OF WATER COMMISSIONERS
416 North State Street
Jackson, Mississippi 39201

CODED

CODED

WATER WELL DRILLERS LOG

11-21 1969 NEIL HUMPHRIN WELLS Pearl River
date well completed DRLG. firm name SERVICE county well located


LANDOWNER: <u>Herford Feels</u> <u>Emigae Blair</u>	description of formations encountered	from	to
<u>Poplarville, Route</u> (mailing address)	<u>surface clay</u>	0	80
WELL LOCATION: <u>13</u> miles <u>West</u> of <u>Poplarville</u> (distance) (direction) (nearest town)	<u>band, no good</u>	80	350
WELL PURPOSE: <u>watering cattle</u> (home, irrigation, municipal, industrial)	<u>Blue clay</u>	350	390
WELL COMPLETION DATA:	<u>Beautiful grey</u> <u>artesian sand</u>	390	430
(1) diameter (inches) <u>4"</u>			
(2) total depth (feet) <u>430</u>			
(3) static water level (feet) <u>100</u> <u>below</u> top of ground.			
(4) casing <u>galv.</u> (material), (depth) <u>210'</u> <u>2 1/2"</u> if telescope see back. (size)			
(5) screen <u>10'</u> (length), (depth to top) <u>2"</u> (size), <u>St. Steel</u> (material)			
(6) pump <u>3</u> (HP), <u>90gpm.</u> (yield gpm), <u>electric</u> (type power)			
(7) electric log <u>No</u> (yes or no)			
(8) how well bottom plugged <u>Johnson</u> <u>back pressure valve</u>			
DRILLERS REMARKS:			

JAN 21 1970

MISS. BD. OF
WATER COMM.

If well telescopes please sketch and show depths.

GROUND LEVEL

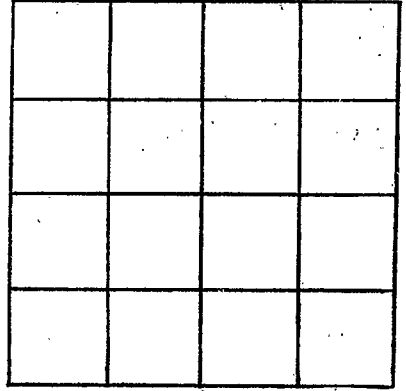

SECTION _____

Please indicate well location X.

ADDITIONAL INFORMATION

If more than one screen,
show locations of each on sketch.