

Pearl River  
E 15  
10-13-69

MISSISSIPPI  
BOARD OF WATER COMMISSIONERS  
416 North State Street  
Jackson, Mississippi 39201

CODED

WATER WELL DRILLERS LOG

10-13 date well completed  
1970 Penton Well Serv firm name  
Pearl River county well located

LANDOWNER: J. K. Amacker  
Rt. 3 New NO BOX  
Poplarville Miss.  
(mailing address)

description of formations encountered	from	to
sandy clay	0	22
Red sand	22	90
Blue clay	90	138
Grey sand	138	150

WELL LOCATION:

sec. 9 T 2 R 18  
7 miles North of Crossroads  
(distance) (direction) (nearest town)

WELL PURPOSE: Home  
(home, irrigation, municipal, industrial)

WELL COMPLETION DATA: 4/12

- (1) diameter (inches) 2"
- (2) total depth (feet) 150
- (3) static water level (feet) 3 below top of ground.
- (4) casing Galv, 145, (material) (depth)  
2 (size) if telescope see back.
- (5) screen 5', 145 (length) (depth to top)  
2" S. Steel (size) (material)
- (6) pump 1/3 12 (HP) (yield gpm)  
Elec (type power)
- (7) electric log NO (yes or no)

(organization running log)

(8) how well bottom plugged B.W. Value


FEB 25 1970

DRILLERS REMARKS:

MISS. BD. OF  
WATER COM.

If well telescopes please sketch and show depths.

GROUND LEVEL

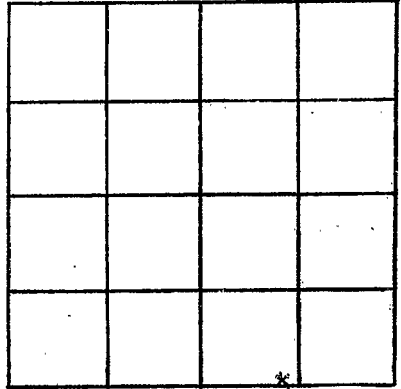

SECTION 9

Please indicate well location X.

ADDITIONAL INFORMATION

If more than one screen, show locations of each on sketch.