

Pearl River  
E 16  
3-9-70

MISSISSIPPI  
BOARD OF WATER COMMISSIONERS  
416 North State Street  
Jackson, Mississippi 39201

**CODED**

WATER WELL DRILLERS LOG

3-9-1970 Howe A. Pool Pearl River  
date well completed firm name county well located

LANDOWNER:	description of formations encountered	from-	to
E. Lee	Clay	0	60
R143	FINE SAND	60	100
Poplarville Miss	SAND & ROCKS	100	105

WELL LOCATION:  
sec 35 T 2 N R 17 E  
10 miles South of Poplarville  
(distance) (direction) (nearest town)

WELL PURPOSE: HOME  
(home, irrigation, municipal, industrial)

- WELL COMPLETION DATA:
- (1) diameter (inches) 4 1/2"
  - (2) total depth (feet) 105'
  - (3) static water level (feet) \_\_\_\_\_ below/above top of ground.
  - (4) casing PVC 100'  
(material) (depth)  
2" (size) if telescope see back.
  - (5) screen 5' 100'  
(length) (depth to top)  
1/2" PVC  
(size) (material)
  - (6) pump 3/4 7 Gal  
(HP) (yield gpm)  
Clear  
(type power)
  - (7) electric log No  
(yes or no)
- (organization running log)

**CODED**

MAR 26 1970


(8) how well bottom plugged  
BACKWASH VALVE

MISS. BD. OF  
WATER COMM.

DRILLERS REMARKS:

If well telescopes please sketch and show depths.

GROUND LEVEL

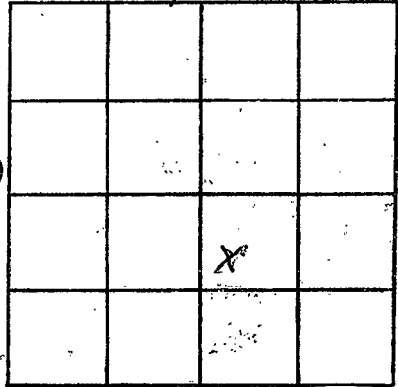

SECTION 35

Please indicate well location X.

ADDITIONAL INFORMATION

If more than one screen, show locations of each on sketch.