

Pearl River
E. 17
6-23-70

MISSISSIPPI
BOARD OF WATER COMMISSIONERS
416 North State Street
Jackson, Mississippi 39201

CODED

WATER WELL DRILLERS LOG

June 23 1970 Early Staffed Well Service Pearl River
date well completed G. S. Smith name county well located

LANDOWNER: ~~Robert Long~~

description of formations encountered from to

Rt 1

Poplarville, Miss
(mailing address)

Chalk 0 15

WELL LOCATION:

sec. 8 T. 28 R. 17
8 miles N of Crossroad
(distance) (direction) (nearest town)

Peagravel & Sand 16 83

WELL PURPOSE:
(home, irrigation, municipal, industrial)

WELL COMPLETION DATA:

- (1) diameter (inches) 4 in
- (2) total depth (feet) 83
- (3) static water level (feet) 20 below top of ground
- (4) casing Plastic 43
(material) (depth)
4 in if telescope see back.
(size)
- (5) screen 10 ft, 73 ft
(length) (depth to top)
4 in, Plastic
(size) (material)
- (6) pump 1/2 1500 gpm
(HP) (yield gpm)
Electric
(type power)
- (7) electric log _____
(yes or no)

CODED

(organization running log)

(8) how well bottom plugged B.W.V.

1970


MISS. BD. OF
WATER COMM.

DRILLERS REMARKS:

Clive Duncan

If well telescopes please sketch and show depths.

GROUND LEVEL

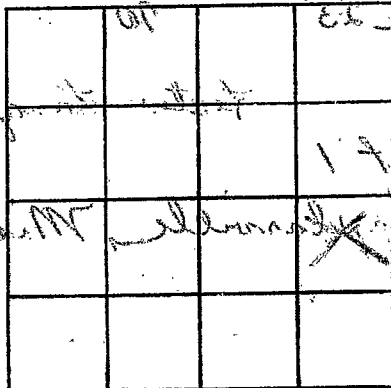

SECTION _____

Please indicate well location X.

ADDITIONAL INFORMATION

If more than one screen, show locations of each on sketch.