

Pearl River
E 18
6-23-70

MISSISSIPPI
BOARD OF WATER COMMISSIONERS
416 North State Street
Jackson, Mississippi 39201

CODED

WATER WELL DRILLERS LOG

June 23 1970 Easley Stafford Well Pearl River
date well completed firm name county well located

LANDOWNER: Justin Long

description of formations encountered

Route 1
Poplarville, Miss.
(mailing address)

Chalk 0 15

WELL LOCATION:
sec. 8 T 2 S R 12 W
4 miles N of Cross Road
(distance) (direction) (nearest town)

Peagravel & sand 15 70

WELL PURPOSE:
(home, irrigation, municipal, industrial)

WELL COMPLETION DATA:

CODED

- (1) diameter (inches) 4
- (2) total depth (feet) 70
- (3) static water level (feet) 20 below above top of ground.
- (4) casing Plastic, 60
(material) (depth)
4 in if telescope see back.
(size)
- (5) screen 10 ft, 60 ft
(length) (depth to top)
4 in, Plastic
(size) (material)
- (6) pump 1/2 1500 gpm
(HP) (yield gpm)
3 hp
(type power)
- (7) electric log
(yes or no)

(organization running log)
- (8) how well bottom plugged B.W.V.


JUN 16 1970

MISS. BD. OF
WATER COMM.

DRILLERS REMARKS:
Clevie Duncan

If well telescopes please sketch and show depths.

GROUND LEVEL

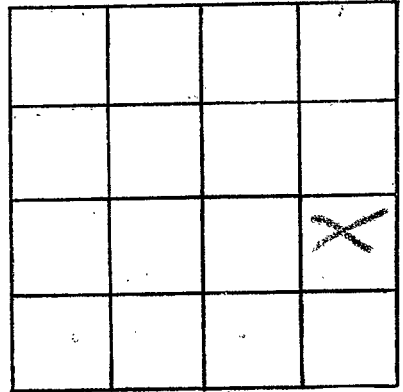

SECTION _____

Please indicate well location X.

ADDITIONAL INFORMATION

If more than one screen, show locations of each on sketch.