

Pearl River

E 19

7-1-70

MISSISSIPPI
 BOARD OF WATER COMMISSIONERS
 416 North State Street
 Jackson, Mississippi 39201

CODED

WATER WELL DRILLERS LOG

7-1 1970
date well completed

McShane Water Well Dr. Pearl River
firm name

Pearl River
county well located

LANDOWNER: Preston Varner

description of formations encountered

from

to

Rt #1 Poplarville, Miss

CLAY	0	20
SAND	20	60
CLAY	60	185
SAND	185	195
CLAY	195	231
SAND	231	

(mailing address)

WELL LOCATION:

sec. 17 T. 2 S. R. 18 E.
4 miles NE of Crossroads
(distance) (direction) (nearest town)

WELL PURPOSE: Industrial
(home, irrigation, municipal, industrial)

WELL COMPLETION DATA:

- (1) diameter (inches) 4"
- (2) total depth (feet) 231'
- (3) static water level (feet) 10 ^{below} above top of ground.
- (4) casing Steel, 126,
(material) (depth)
(size) if telescope see back.
- (5) screen None,
(length) (depth to top)
Open End
(size) (material)
- (6) pump None, 60
(HP) (yield gpm)
(type power)
- (7) electric log NO
(yes or no)

CODED

(organization running log)

(8) how well bottom plugged Open
END


JUL 20 1970

MISS. BD. OF
WATER COMM.

DRILLERS REMARKS:

If well telescopes please sketch and show depths.

⁴⁴
GROUND LEVEL

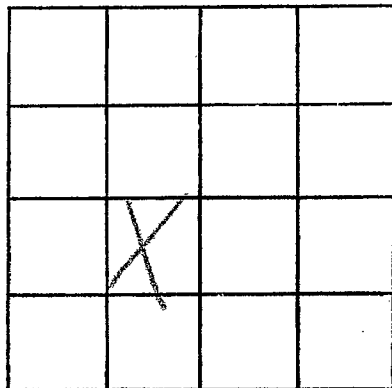

SECTION 3

Please indicate well location X.

ADDITIONAL INFORMATION

J

If more than one screen, show locations of each on sketch.