

PEARL RIVER  
E20  
8-1-70

MISSISSIPPI  
BOARD OF WATER COMMISSIONERS  
416 North State Street  
Jackson, Mississippi 39201

CODED

WATER WELL DRILLERS LOG

8-1-70 19 Harold Woodward Pearl River  
date well completed firm name county well located  
of Poplarville, Miss.

| LANDOWNER:   | description of formations encountered | from      | to            |
|--|---------------------------------------|-----------|---------------|
| <u>Jellison</u><br><u>Neuman</u>   |                                       |           |               |
| <u>ct. 1 Poplarville, Miss.</u><br>(mailing address)   | <u>Top sand</u>                       | <u>0</u>  | <u>15</u>     |
| WELL LOCATION:<br>sec. <u>8</u> T. <u>2</u> R. <u>12</u><br><u>7</u> miles <u>North</u> of <u>Coarswade</u><br>(distance) (direction) (nearest town) | <u>Clay</u>                           | <u>15</u> | <u>30</u>     |
| WELL PURPOSE: <u>Home</u><br>(home, irrigation, municipal, industrial)   | <u>fine sand</u>                      | <u>30</u> | <u>40</u>     |
| WELL COMPLETION DATA:<br>(1) diameter (inches) <u>2"</u>   | <u>brown rock</u>                     |           |               |
| (2) total depth (feet) <u>78 ft.</u>   | <u>dry sand</u>                       | <u>40</u> | <u>50</u>     |
| (3) static water level (feet) <u>23'</u> below top of ground.  |                                       |           |               |
| (4) casing <u>plastic 73'</u><br>(material) (depth)  |                                       |           |               |
| <u>set at</u><br>(size) If telescope see back.   |                                       |           | <u>78 ft.</u> |
| (5) screen <u>5' 73'</u><br>(length) (depth to top)  | <u>Very coarse</u>                    |           |               |
| <u>2"</u><br>(size) (material)   | <u>white sand</u>                     | <u>59</u> | <u>78</u>     |
| (6) pump <u>1/2 750 Hr.</u><br>(HP) (yield gpm)  |                                       |           |               |
| <u>115 Hc</u><br>(type power)  |                                       |           |               |
| (7) electric log <u>no</u><br>(yes or no)  |                                       |           |               |
| <u>Self</u><br>(organization running log)  |                                       |           |               |
| (8) how well bottom plugged <u>2" 55</u>   |                                       |           |               |
| <u>Bial. Wash</u>  |                                       |           |               |

CODED


AUG 25 1970

DRILLERS REMARKS:

MISS. BD. OF  
WATER COMM.

If well telescopes please sketch and show depths.

GROUND LEVEL

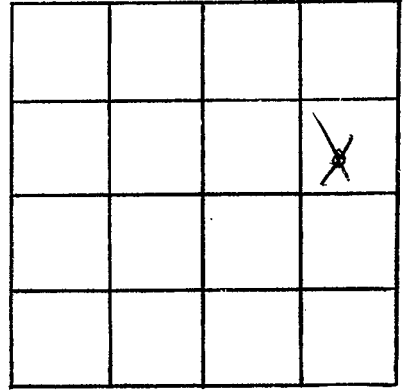

SECTION 8

Please indicate well location X.

ADDITIONAL INFORMATION

If more than one screen,  
show locations of each on sketch.