

PEARL RIVER
E 21
10-28-70

MISSISSIPPI
BOARD OF WATER COMMISSIONERS
416 North State Street
Jackson, Mississippi 39201

CODED

WATER WELL DRILLERS LOG

Oct. 28 1970 Harold Woodward Pearl River
date well completed firm name county well located

LANDOWNER: Wesley
Charles McArthur Church
Rt. 1 Poplarville, Miss.
(mailing address)

description of formations encountered	from	to
Red Clay	0	11
fine brown sand	11	30
white sand & soft rock	30	60
Very good sand	60	70

WELL LOCATION:
sec. 4 T. 2 S. R. 17 W.
13 miles north of Poplarville
(distance) (direction) (nearest town)

WELL PURPOSE: Church
(home, irrigation, municipal, industrial)

- WELL COMPLETION DATA:
- (1) diameter (inches) 2"
 - (2) total depth (feet) 70'
 - (3) static water level (feet) 22' below top of ground.
 - (4) casing plastic, 65' (material) (depth)
2" (size) if telescope see back.
 - (5) screen 5" length, 65' (depth to top)
2" (size) plastic (material)
 - (6) pump 1/2 HP, 690 (yield gpm)
115 (type power)
 - (7) electric log 70 (yes or no)
YPA (organization running log)
 - (8) how well bottom plugged 2" SS

CODED

[Handwritten signature]


OCT 30 1970

MISS. BD. OF
WATER COMM.

DRILLERS REMARKS:

If well telescopes please sketch and show depths.

GROUND LEVEL

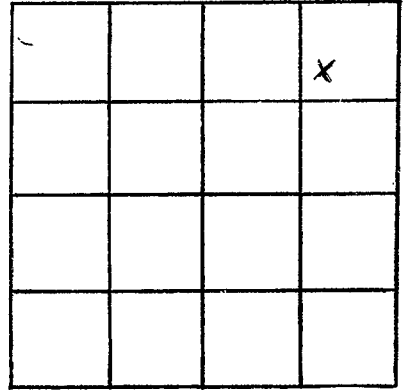

SECTION 4

Please indicate well location X.

ADDITIONAL INFORMATION

If more than one screen,
show locations of each on sketch.