

PEARL RIVER

E22

10-11-70

MISSISSIPPI BOARD OF WATER COMMISSIONERS
416 North State Street
Jackson, Mississippi 39201

CODED

WATER WELL DRILLERS LOG

10-11-1970
date well completed

70 - Red Martin Water well serv. Pearl River
firm name county well located

LANDOWNER: George C

Delaney

RT 1 Box 113

pearlrivermiss (mailing address)

WELL LOCATION:

sec. 39 T 2 N R 17 E
S W

1.2 miles West of pearlrivermiss
(distance) (direction) (nearest town)

WELL PURPOSE: home
(home, irrigation, municipal, industrial)

WELL COMPLETION DATA:

- (1) diameter (inches) 1 1/2"
- (2) total depth (feet) 60
- (3) static water level (feet) 46 below top of ground.
- (4) casing 4" pvc 50
(material) (depth)
 if telescope see back.
(size)
- (5) screen 10 50
(length) (depth to top)
6.12 pvc
(size) (material)
- (6) pump used
(HP) (yield gpm)
AC
(type power)
- (7) electric log no
(yes or no)

(organization running log)

(8) how well bottom plugged
good sharp backwash

DRILLERS REMARKS:

description of formations encountered

from to

top clay

6'

sand

6' 60'


CODED

DEC 21 1970

MISS. BD. OF WATER COMMISSIONERS

If well telescopes please sketch and show depths.

GROUND LEVEL

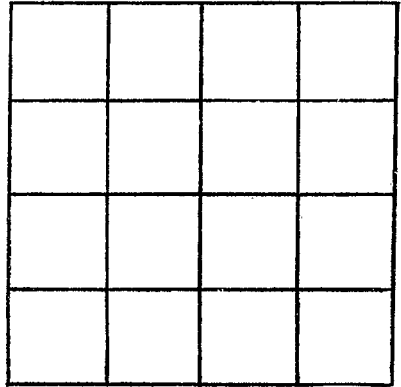

SECTION _____

Please indicate well location X.

ADDITIONAL INFORMATION

If more than one screen,
show locations of each on sketch.