

PEARL RIVER
E 23
5-5-71

MISSISSIPPI
BOARD OF WATER COMMISSIONERS
416 North State Street
Jackson, Mississippi 39201

CODED

WATER WELL DRILLERS LOG

5-5 1971 *Messiah's Water Well Drilling Pearl River*
date well completed firm name county well located

LANDOWNER *Preston Varner*
Rt #1 Poplarville, Miss
(mailing address)

description of formations encountered	depth	
	from	to
<i>Clay</i>	<i>0</i>	<i>20</i>
<i>Sand</i>	<i>20</i>	<i>60</i>
<i>Clay</i>	<i>60</i>	<i>190</i>
<i>Sand</i>	<i>190</i>	<i>231</i>
<i>Clay</i>	<i>231</i>	<i>240</i>
<i>Sand</i>	<i>240</i>	<i>276</i>

WELL LOCATION:
sec. *17* T. *2* N. R. *18* E
4 miles *NE* of *Cross Road*
(distance) (direction) (nearest town)

WELL PURPOSE: *Industrial*
(home, irrigation, municipal, industrial)

- WELL COMPLETION DATA:
- (1) diameter (inches) *2 1/2"*
 - (2) total depth (feet) *276*
 - (3) static water level (feet) *10* ^{below} above top of ground.
 - (4) casing *Steel* *126*
(material) (depth)
3/4 if telescope see back.
(size)
 - (5) screen *None*
(length) (depth to top)
Open End
(size) (material)
 - (6) pump *None* *60*
(HP) (yield gpm)
 - (type power)
 - (7) electric log *No*
(yes or no)
 - (organization running log)
 - (8) how well bottom plugged *open*
end -

CODED


NOV 15 1971

MISS. Bd. OF
WATER COMM.

DRILLERS REMARKS:

If well telescopes please sketch and show depths.

GROUND LEVEL

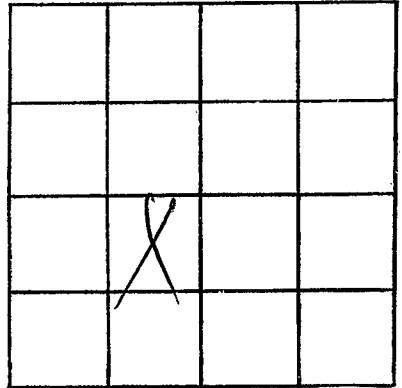

SECTION 3

Please indicate well location X.

ADDITIONAL INFORMATION

If more than one screen, show locations of each on sketch.