

PEARL RIVER  
E 30  
2-22-73

MISSISSIPPI  
BOARD OF WATER COMMISSIONER  
416 North State Street  
Jackson, Mississippi 39201

**CODED**

WATER WELL DRILLERS LOG

2-22 date well completed  
1973 McShane Water Well Co. firm name  
Pearl River county well located

LANDOWNER: Hiram Steufert  
Poplarville, Miss

description of formations encountered	from	to
<u>Top Soil</u>	<u>0</u>	<u>3</u>
<u>Clay</u>	<u>3</u>	<u>28</u>
<u>Fine sand</u>	<u>28</u>	<u>85</u>
<u>Coarse sand</u>	<u>85</u>	<u>105</u>

(mailing address)

WELL LOCATION:  
sec. 3 T. 22 N. R. 12 E.  
9 miles E-NE of Crossroad  
(distance) (direction) (nearest town)

WELL PURPOSE: home  
(home, irrigation, municipal, industrial)

- WELL COMPLETION DATA:
- (1) diameter (inches) 4
  - (2) total depth (feet) 105
  - (3) static water level (feet) 38 below above top of ground.
  - (4) casing PVC, 105  
(material) (depth)  
(size) if telescope see back.
  - (5) screen 10', 95'  
(length) (depth to top)  
4, PVC  
(size) (material)
  - (6) pump 1/2, 15  
(HP) (yield gpm)  
Electric  
(type power)
  - (7) electric log no  
(yes or no)
  - (organization running log)
  - (8) how well bottom plugged Back  
Pressure gauge


**CODED**

FEB 28 1973

DRILLERS REMARKS:

If well telescopes please sketch and show depths.

GROUND LEVEL

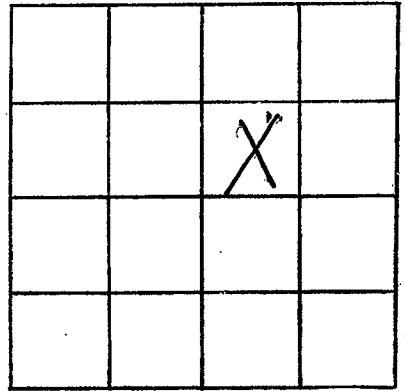

SECTION 3

Please indicate well location X.

ADDITIONAL INFORMATION

If more than one screen, show locations of each on sketch.