

PEARL RIVER  
E 31  
5-10-73

MISSISSIPPI  
BOARD OF WATER COMMISSIONERS  
416 North State Street  
Jackson, Mississippi 39201

**CODED**

WATER WELL DRILLERS LOG

5/10 1973 Bud Benton & Son Pearl River  
date well completed firm name county well located

LANDOWNER: Edd Gross  
Applwell Miss.

description of formations encountered	from	to
Red shale	0	21
Red sand	21	90
White shale	90	130
Red sand	130	170

(mailing address)

WELL LOCATION:

sec. 30 T 2 N R 17 E  
16 miles W of Applwell  
(distance) (direction) (nearest town)

WELL PURPOSE: house  
(home, irrigation, municipal, industrial)

WELL COMPLETION DATA:

- (1) diameter (inches) 2"
- (2) total depth (feet) 170
- (3) static water level (feet) 68 below above top of ground.
- (4) casing galv. 165'  
(material) (depth)  
1 if telescope see back.  
(size)
- (5) screen 2x5 165'  
(length) (depth to top)  
2x5 galv. no 12  
(size) (material)
- (6) pump 1 650  
(HP) (yield gpm)  
Elect  
(type power)
- (7) electric log \_\_\_\_\_  
(yes or no)  
  
(organization running log)
- (8) how well bottom plugged hard  
sharp


**CODED**

DRILLERS REMARKS:

MAY 22 1973

If well telescopes please sketch and show depths.

GROUND LEVEL

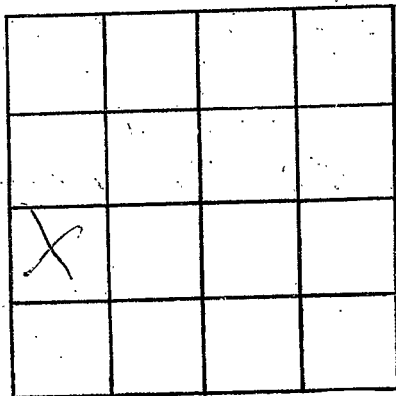

SECTION \_\_\_\_\_

Please indicate well location X.

ADDITIONAL INFORMATION

If more than one screen, show locations of each on sketch.