

239740

MISSISSIPPI BOARD OF WATER COMMISSIONERS  
416 North State Street  
Jackson, Mississippi 39201

CODED

P.R.  
E33  
9-19-73

WATER WELL DRILLERS LOG

9-19

1973

Lumpkin Well Serv. firm name

Paul River county well located

LANDOWNER: Larry Lumpkin

description of formations encountered

from

to

Rt. 3

Poplarville, Miss.  
(mailing address)

Clay 0 60  
Sand 60 145  
Clay 145 170  
Sand 170 220  
Clay 220 350  
Sand 350 405

WELL LOCATION:

sec 25 T 2 N R 17 E  
3.12 miles N. of White Oak

WELL PURPOSE: home  
(home, irrigation, municipal, industrial)

CODED

WELL COMPLETION DATA:

- (1) diameter (inches) 2"
- (2) total depth (feet) 405
- (3) static water level (feet) 50' below top of ground.
- (4) casing 2" P.V.C. 400'  
(material) (depth)
- 2" (size) If telescope see back.
- (5) screen 5' 400'  
(length) (depth to top)
- 2" (size) P.V.C. (material)
- (6) pump 1 300 g.p.h.  
(HP) (yield gpm)
- E. Lec. (type power)
- (7) electric log No.  
(yes or no)

(organization running log)


(8) how well bottom plugged Sand Sheet

DRILLERS REMARKS:

OCT 26 1973

If well telescopes please sketch and show depths.

GROUND LEVEL

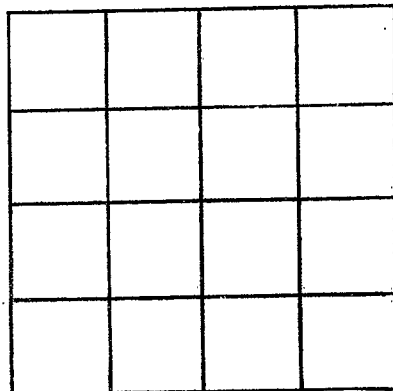

SECTION \_\_\_\_\_

Please indicate well location X.

ADDITIONAL INFORMATION

If more than one screen,  
show locations of each on sketch.