

Pearl River
E 34
11-25-73

MISSISSIPPI
 BOARD OF WATER COMMISSIONERS
 416 North State Street
 Jackson, Mississippi 39201

CODED

WATER WELL DRILLERS LOG

11-25 1973 Simpson Well Ser. Pearl River
 date well completed firm name county well located

LANDOWNER:
Jimmie Smith
Poplarville, Miss
 (mailing address)

description of formations encountered	from	to
Clay	0	35
Sand	35	315
Clay	315	400
Sand	400	466

WELL LOCATION:
 sec. 27 T 2 N R 17 E
5 miles W. of Whitfield
 (distance) (direction) (nearest town)

WELL PURPOSE: Home
 (home, irrigation, municipal, industrial)

CODED

- WELL COMPLETION DATA:
- (1) diameter (inches) 2"
 - (2) total depth (feet) 466'
 - (3) static water level (feet) 110' below top of ground.
 - (4) casing P.V.C., 461'
 (material) (depth)
2" If telescope see back.
 (size)
 - (5) screen 5', 461'
 (length) (depth to top)
2", P.V.C.
 (size) (material)
 - (6) pump 1, 210 G.P.M.
 (HP) (yield gpm)
Electric
 (type power)
 - (7) electric log no
 (yes or no)
 - (8) how well bottom plugged Sand Shale


DRILLERS REMARKS:

NOV 29 1973

MISS. RD. (P)
 WATER COMM.

If well telescopes please sketch and show depths.

GROUND LEVEL

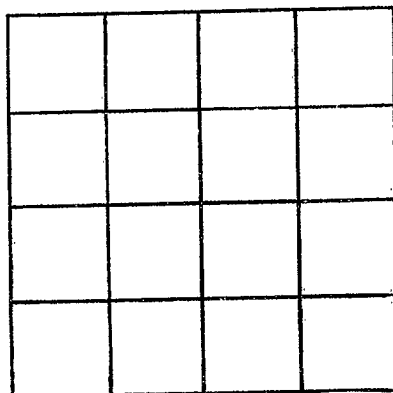

SECTION _____

Please indicate well location X.

ADDITIONAL INFORMATION

If more than one screen,
show locations of each on sketch.