

P.R.
E-36
11-6-74

MISSISSIPPI
BOARD OF WATER COMMISSIONERS
416 North State Street
Jackson, Mississippi 39201

CODED

WATER WELL DRILLERS LOG


11-6 date well completed 1974 Lempkin Well Sec Pearl River firm name county well located

LANDOWNER:	description of formations encountered	from	to
Mr. Robert Schmielt Rt. Poplarville, Miss (mailing address)	Clay Sand	0 80	80 266
WELL LOCATION: sec. 9 T. 23 N. R. 17 E 10 miles E.N.E. of Poplarville (distance) (direction) (nearest town)			
WELL PURPOSE: Home (home, irrigation, municipal, industrial)			
WELL COMPLETION DATA: (1) diameter (inches) 2" (2) total depth (feet) 266' (3) static water level (feet) 90' below top of ground. (4) casing P.V.C., 260, (material) (depth) 2" (size) if telescope see back. (5) screen 6', 260 (length) (depth to top) 2" (size) P.V.C. (material) (6) pump 1hp, 480 (HP) 2ph. (yield gpm) Elec. (type power) (7) electric log No. (yes or no)			
(organization running log) (8) how well bottom plugged Sand Blank	DECEMBER 1974 DEC - 6 1974		
DRILLERS REMARKS:	MISS. BD. OF WATER COMM.		

CODED

If well telescopes please sketch and show depths.

GROUND LEVEL

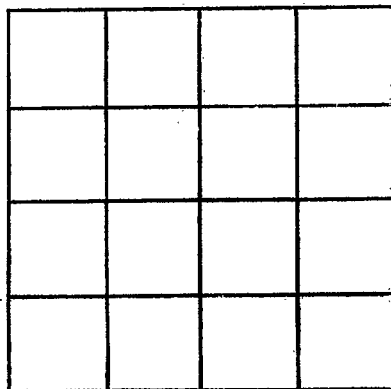

SECTION _____

Please indicate well location X.

ADDITIONAL INFORMATION

If more than one screen, show locations of each on sketch.