

P.R.  
E38  
1174

MISSISSIPPI  
BOARD OF WATER COMMISSIONERS  
416 North State Street  
Jackson, Mississippi 39201

CODED

WATER WELL DRILLERS LOG

Nov. 1974  
date well completed

E.B. Sherrard  
firm name

136 Pearl River  
county well located


LANDOWNER:	description of formations encountered	from	to
D. F. Walker Columbia, Ms. (mailing address)	SANDY WITH CLAY STREAKS LOOSE COARSE SAND & PEACH.	0	38' 38' 80'
<b>WELL LOCATION:</b>			
sec 37 T 2 N R 17 E 12 miles SW of Poplarville (distance) (direction) (nearest town)			
<b>WELL PURPOSE:</b>			
(home irrigation, municipal, industrial)			
<b>WELL COMPLETION DATA:</b>			
(1) diameter (inches) 2"			
(2) total depth (feet) 80'			
(3) static water level (feet) 30' below above top of ground.			
(4) casing pl. 75' (material) (depth)			
2" (size) If telescope see back.			
(5) screen 5' (length) (depth to top)			
2" (size) pl. (material)			
(6) pump 1 (HP) 7 (yield gpm)			
E (type power)			
(7) electric log (yes or no)			
(organization running log)			
(8) how well bottom plugged BWD			
<b>DRILLERS REMARKS:</b>			

RECEIVED  
MAY - 8 1975

MISS. BD. OF WATER COMMISSIONERS

If well telescopes please sketch and show depths.

GROUND LEVEL

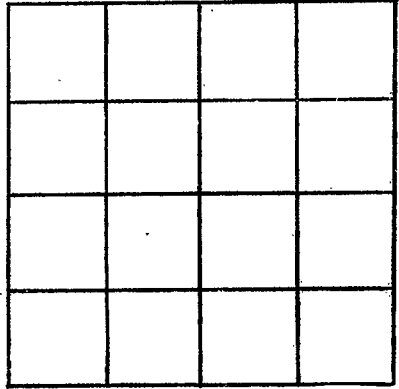

SECTION \_\_\_\_\_

Please indicate well location X.

ADDITIONAL INFORMATION

If more than one screen, show locations of each on sketch.