

Pearl River
E 41
7-21-75

MISSISSIPPI
 BOARD OF WATER COMMISSIONERS
 416 North State Street
 Jackson, Mississippi 39201

WATER WELL DRILLERS LOG

7-21- 1975 Leuppin Well Dr. Pearl River
 date well completed firm name county well located

LANDOWNER:
Procheaux
Poplarville
 (mailing address)

WELL LOCATION:
 sec 22 T N R 17E
12 2 S 170
12 miles W of Poplarville
 (distance) (direction) (nearest town)

WELL PURPOSE: Home
 (home, irrigation, municipal, industrial)

- WELL COMPLETION DATA:
- (1) diameter (inches) 4" x 2"
 - (2) total depth (feet) 472'
 - (3) static water level (feet) 100' below top of ground.
 - (4) casing P.V.C., 452'
 (material) (depth)
4" x 2" If telescope see back.
 (size)
 - (5) screen 20', 452'
 (length) (depth to top)
2", P.V.C.
 (size) (material)
 - (6) pump 2 SUB, 2500
 (HP) (yield gpm)
Elec.
 (type power)
 - (7) electric log No.
 (yes or no)
No.
 (organization running log)
 - (8) how well bottom plugged Sand Shrub

description of formations encountered	from	to
Clay	0	40
Sand	40	90
Clay	90	130
Sand	130	350
Clay	350	390
Sand	390	472

DRILLERS REMARKS:

NOV 24 1975
 MISS. BOARD OF WATER COMMISSIONERS

If well telescopes please sketch and show depths.


GROUND LEVEL

Sch. No P.V.E
260' X 4"

Sch. No P.V.E.
212' X 2"

SCREEN
20' X 2"

in Sand
shrub

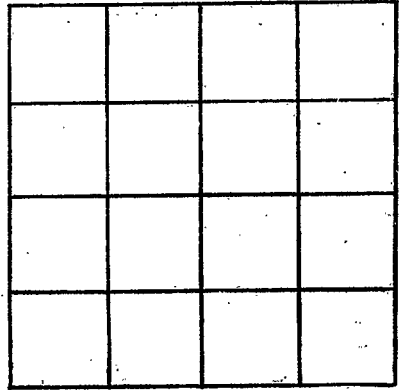

SECTION _____

Please indicate well location X.

ADDITIONAL INFORMATION

If more than one screen,
show locations of each on sketch.