

MISSISSIPPI DEPARTMENT OF NATURAL RESOURCES
Bureau of Land and Water Resources

Southport Mall

P.O. Box 10631

Jackson, Mississippi 39209

WATER WELL DRILLERS LOG

CODED

Pearl River
E 48
1/10/85

1-10-85 Griner Drilling Service, Inc. Pearl River

date well completed

firm name

county well located

LANDOWNER:

Prosper Energy Corp.
P.O. Box 4096
Houma, La. 70361
(mailing address)

description of formations encountered

from

to

Fill

0 9

clay

9 65

WELL LOCATION: 1900'S + 1500'S

sec. 27 T. 2 N. R. 17 E. of

No. 1 Southern Mineral Corp. Poplarville
Unit 10-1 (direction) of (nearest town)

sand, pea gravel

65 250

streaked

250 336

WELL PURPOSE: oilfield supply
(home, irrigation, municipal, industrial)

sand, pea gravel

336 420

WELL COMPLETION DATA:

- (1) diameter (inches) 4"
(2) total depth (feet) 420'
(3) static water level (feet) 70' below above top of ground.

(4) casing Steel 420'
(material) (depth)

4"
(size) If telescope see back.

(5) screen 42' 378'
(length) (depth to top)

4" perforated
(size) (material)

(6) pump - 75
(HP) (yield gpm)

AC
(type power)

(7) electric log (yes or no) (no)

(organization running log)

(8) how well bottom plugged orange peel

DRILLERS REMARKS:


CODED

RECEIVED
JAN 24 1985

Department of Natural Resources
Bureau of Land & Water Resources

If well telescopes please sketch and show depths.

GROUND LEVEL

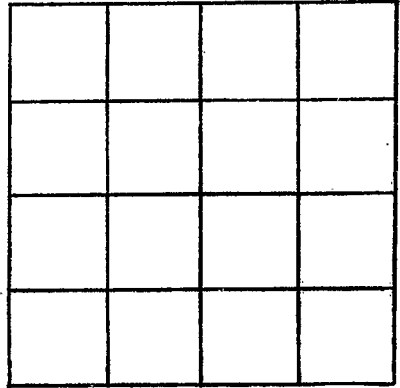

SECTION _____

Please indicate well location X.

ADDITIONAL INFORMATION

If more than one screen,
show locations of each on sketch.