

F52  
 Pearl River  
 8-19-85

MISSISSIPPI  
 BOARD OF WATER COMMISSIONERS  
 416 North State Street  
 Jackson, Mississippi 39201

CODED

WATER WELL DRILLERS LOG

Griner Drilling  
 Service, Inc.

Pearl  
 River

date well completed

firm name

county well located

LANDOWNER:

Prosper Energy Corp.  
 P.O. Box 4096  
 Houma, La. 70361  
 (mailing address)

description of formations  
 encountered

from

to

clay - streaked	0	63
sand, pea gravel	63	315
clay, streaked	315	420
sand,	420	462
streaked, clay	462	504

WELL LOCATION:

1900' N + 2200' W  
 sec 22 T 2 N R 17 E of  
 No. 3 G.H. Williams S. Stewart Field  
 22-10 (distance) (direction) (nearest town)

WELL PURPOSE: oilfield supply  
 (home, irrigation, municipal, industrial)

WELL COMPLETION DATA:

- (1) diameter (inches) 4"
- (2) total depth (feet) 504'
- (3) static water level (feet) 100' below top of ground.
- (4) casing Steel, 315' (material) (depth)  
 4" (size) if telescope see back.
- (5) screen 42', 273' (length) (depth to top)  
 4" perforated (size) (material)
- (6) pump - 75 (HP) (yield gpm)  
 AC (type power)
- (7) electric log (yes or no) (no)
- (organization running log)
- (8) how well bottom plugged orange  
 peel


DRILLERS REMARKS:

RECEIVED  
 SEP 23 1985

Department of Natural Resources  
 Bureau of Land & Water Resources

If well telescopes please sketch and show depths.

GROUND LEVEL

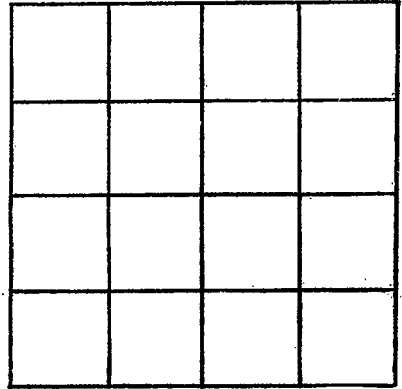

SECTION \_\_\_\_\_

Please indicate well location X.

ADDITIONAL INFORMATION

If more than one screen,  
show locations of each on sketch.