

MISSISSIPPI DEPARTMENT

Bureau of Land and Water

Southport Mall

P.O. Box 10631

Jackson, Mississippi 39209

WATER WELL DRILLERS LOG

CODED

E 53
Pearl River
9-29-85

Griner Drilling Service, Inc.

Pearl River

9-29-85 date well completed

Griner Drilling Service, Inc. firm name

Pearl River county well located

LANDOWNER:	description of formations encountered	from	to
Prosper Energy Corp. P.O. Box 4096 Houma, La. 70361 (mailing address)	SAND	0	105
	chalk	105	147
WELL LOCATION: 2100'S 4 2500'E sec. 26 T. 2 N. R. 17 E. OF No. 1 Southern White Sand Mine (distance) (direction) (nearest town)	SAND	147	294
	chalk	294	305
WELL PURPOSE: oilfield supply (home, irrigation, municipal, industrial)			

- WELL COMPLETION DATA:
- (1) diameter (inches) 4"
  - (2) total depth (feet) 305'
  - (3) static water level (feet) 30'  below  above top of ground.
  - (4) casing steel, 294'  
(material) (depth)  
3"  
(size) if telescope see back.
  - (5) screen 42', 252'  
(length) (depth to top)  
3" perforated  
(size) (material)
  - (6) pump —, 100  
(HP) (yield gpm)  
AC  
(type power)
  - (7) electric log (yes or no)  no

(organization running log)

(8) how well bottom plugged orange peel


DRILLERS REMARKS:

RECEIVED  
OCT 10 1985

Department of Natural Resources  
Bureau of Land & Water Resources

If well telescopes please  
sketch and show depths.

GROUND LEVEL

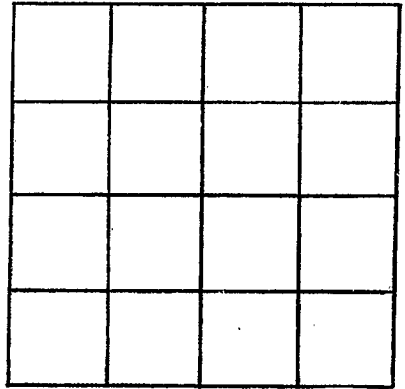

SECTION \_\_\_\_\_

Please indicate well location X.

ADDITIONAL INFORMATION

If more than one screen,  
show locations of each on sketch.