

MISSISSIPPI DEPARTMENT OF NATURAL RESOURCES

Bureau of Land and Water Resources

Southport Mall

P.O. Box 10631

Jackson, Mississippi 39209

WATER WELL DRILLERS LOG

CODED

PEARL RIVER
E5A
8-3-85

8/30/85 date well completed 1985 Penton & Son firm name Pearl River county well located

LANDOWNER: Maple Energy
Brandon Miss
PO 797, 39042
(mailing address)

Description of formations encountered	from	to
Red Shale	0	30
Red sand	30	120
White shale	120	175
Blue shale	175	250
gray sand	250	350
Black shale	350	440
Blue sand	440	500

WELL LOCATION:
sec. 22 T. 2 N R. 17 E
15 miles W
(distance) (direction) (nearest town)

WELL PURPOSE: Industrial
(home, irrigation, municipal, industrial)

- WELL COMPLETION DATA:
- (1) diameter (inches) 4
 - (2) total depth (feet) 500
 - (3) static water level (feet) 90 below top of ground.
 - (4) casing pvc 500
(material) (depth)
 - 1 1/2 if telescope see back.
(size)
 - (5) screen 480 480
(length) (depth to top)
 - 12 pvc
(size) (material)
 - (6) pump 1 1/2 1350
(HP) (yield gpm)
 - Elect
(type power)
 - (7) electric log no
(yes or no)

(organization running log)
(8) how well bottom plugged good


DRILLERS REMARKS:

RECEIVED
NOV 2 1985

Department of Natural Resources
Bureau of Land & Water Resources

If well telescopes please sketch and show depths.

GROUND LEVEL

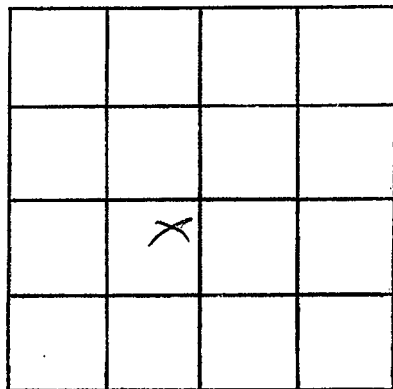

SECTION _____

Please indicate well location X.

ADDITIONAL INFORMATION

If more than one screen,
show locations of each on sketch.