

MISSISSIPPI DEPARTMENT OF NATURAL RESOURCES

Bureau of Land and Water Resources

Southport Mall

P.O. Box 10631

Jackson, Mississippi 39209

WATER WELL DRILLERS LOG

PEARL RIVER
E 55

CODED

11-9-85 Griner Drilling Service, Inc. Pearl River

date well completed

firm name

county well located

LANDOWNER:

Prosper Energy Corp.
P.O. Box 4096
Houma, La. 70361
(mailing address)

description of formations encountered

from

to

SAND

0 20

CLAY

20 84

WELL LOCATION: 1900N + 2200W

sec. 22 T. 2 N. R. 17 E. of

SAND + P. GRAVEL 84 340

No. 2 Poplarville SE/40R
6.4 miles (distance) Williams (nearest town)

CLAY

340 345

WELL PURPOSE: OILFIELD SUPPLY UNIT 1510

WELL COMPLETION DATA:

- (1) diameter (inches) 4"
- (2) total depth (feet) 345'
- (3) static water level (feet) 60' below top of ground.
- (4) casing steel, 336' (material) (depth)
4" (size) if telescope see back.
- (5) screen 42', 294' (length) (depth to top)
4" perforated (size) (material)
- (6) pump — 75 (HP) (yield gpm)
AC (type power)
- (7) electric log (yes or no)

CODED

(organization running log)

(8) how well bottom plugged ORANGE peel


DRILLERS REMARKS:

RECEIVED
DEC 18 1985

Department of Natural Resources
Bureau of Land & Water Resources

If well telescopes please sketch and show depths.

GROUND LEVEL

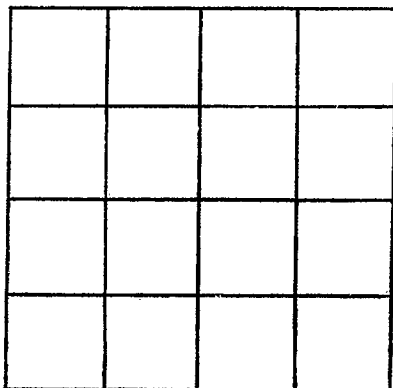

SECTION _____

Please indicate well location X.

ADDITIONAL INFORMATION

If more than one screen,
show locations of each on sketch.