

MISSISSIPPI DEPARTMENT OF NATURAL RESOURCES

Bureau of Land and Water Resources

Southport Mall

P.O. Box 10631

Jackson, Mississippi 39209

WATER WELL DRILLERS LOG

CODED

Pearl River  
E 56

Griner Drilling Service, INC.

Pearl River

1-26-86  
date well completed

Griner Drilling Service, INC.  
firm name

Pearl River  
county well located

LANDOWNER:

Prosper Energy Corp.  
P.O. Box 4096  
Houma, La. 70361  
(mailing address)

description of formations encountered

from

to

clay, sand

0 105

gravel, sand

105 265

clay, sand

265 294

WELL LOCATION: 1750' N x 1750' W

sec. 10 T. 2 N. R. 17 E. of

No. 1 Southern Minerals 10-10 Poplarville  
(distance) miles (direction) (nearest town)

WELL PURPOSE: oilfield supply  
(home, irrigation, municipal, industrial)

WELL COMPLETION DATA:

- (1) diameter (inches) 4"
- (2) total depth (feet) 294'
- (3) static water level (feet) 50' <sup>(below)</sup> <sub>(above)</sub> top of ground.

- (4) casing steel 252'  
(material) (depth)  
4"  
(size) if telescope see back.

- (5) screen 42' 210'  
(length) (depth to top)  
4" perforated  
(size) (material)

- (6) pump — 50-60  
(HP) (yield gpm)  
AC  
(type power)

- (7) electric log (yes or no)

(organization running log)

- (8) how well bottom plugged orange peel

DRILLERS REMARKS:

(sand water well on location)

No. 2 water well


CODED

RECEIVED  
FEB 10 1986

Department of Natural Resources  
Bureau of Land and Water Resources  
Jackson, Mississippi

If well telescopes please  
sketch and show depths.

GROUND LEVEL

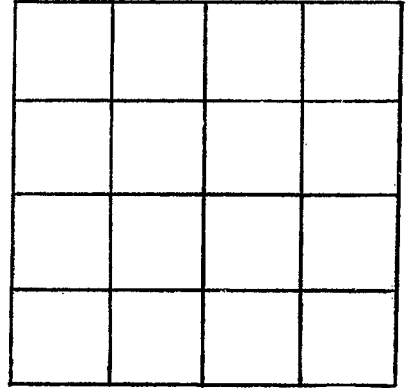

SECTION \_\_\_\_\_

Please indicate well location X.

ADDITIONAL INFORMATION

If more than one screen,  
show locations of each on sketch.