

MISSISSIPPI DEPARTMENT OF NATURAL RESOURCES

Bureau of Land and Water Resources

Southport Mall

P.O. Box 10631

Jackson, Mississippi 39209

WATER WELL DRILLERS LOG

CODED

Griner Drilling Service, Inc.

Pearl River

Pearl River
E 57

1-23-86
date well completed

firm name

county well located


LANDOWNER:	description of formations encountered	from	to
Prosper Energy Corp. P.O. Box 4096 Houma, La. 70361 (mailing address)	clay	0	21
WELL LOCATION: 1750' N + 1750' W sec. 10 T 2 N R 17 E of No. 1 Southern Minerals, Inc. Paplarville (distance) (direction) (nearest town)	clay, sand	21	63
WELL PURPOSE: oilfield supply (home, irrigation, municipal, industrial)	sand, gravel	63	273
WELL COMPLETION DATA:	clay, sand	273	336
(1) diameter (inches) 4"	clay	336	378
(2) total depth (feet) 378'	CODED		
(3) static water level (feet) 50' below above top of ground.			
(4) casing steel 273' (material) (depth) 4" (size) if telescope see back.			
(5) screen 42' 231' (length) (depth to top) 4" perforated (size) (material)			
(6) pump — 65 (HP) (yield gpm) AC (type power)			
(7) electric log (yes or no)			
(organization running log)			
(8) how well bottom plugged ORANGE peel			
DRILLERS REMARKS:			

FEB 18 1986

Department of Natural Resources
Bureau of Land & Water Resources

If well telescopes please
sketch and show depths.

GROUND LEVEL

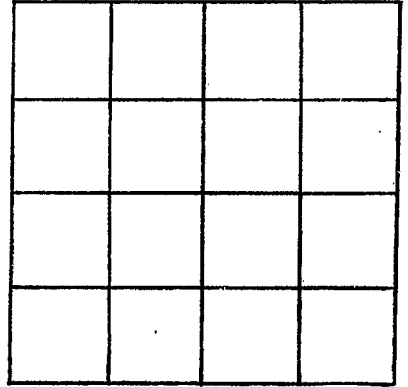

SECTION _____

Please indicate well location X.

ADDITIONAL INFORMATION

If more than one screen,
show locations of each on sketch.