

MISSISSIPPI DEPARTMENT OF NATURAL RESOURCES

Bureau of Land and Water Resources

Southport Mall

P.O. Box 10631

Jackson, Mississippi 39209

WATER WELL DRILLERS LOG

CODED

Pearl River
E 58

1-5-86 Griner Drilling Service, Inc. Pearl River
 date well completed firm name county well located

LANDOWNER:
 Prosper Energy Corp.
 P.O. Box 4096
 Houma, La. 70361
 (mailing address)

description of formations encountered	from	to
chalk	0	42
streaked	42	73
SAND	73	179
streaked	179	220
SAND, pea gravel	220	334
chalk	334	336

WELL LOCATION: 1500N + 1500W
 sec. 21 T. 2 N. R. 17 E. sec. 9 of
 No. 1 Southern Minerals
 21-10 (distance) Poplarville (direction) (nearest town)
 Fried

WELL PURPOSE: oilfield supply
 (home, irrigation, municipal, industrial)

- WELL COMPLETION DATA:
- (1) diameter (inches) 4"
 - (2) total depth (feet) 336'
 - (3) static water level (feet) 70' below above top of ground.
 - (4) casing steel, 336'
 (material) (depth)
4"
 (size) If telescope see back.
 - (5) screen 42', 294'
 (length) (depth to top)
4", perforated
 (size) (material)
 - (6) pump — 95
 (HP) (yield gpm)
AC
 (type power)
 - (7) electric log — (yes or no)
 (organization running log)
 - (8) how well bottom plugged orange
peel

CODED


RECEIVED
 FEB 18 1986

Department of Natural Resources
 Bureau of Land & Water Resources

DRILLERS REMARKS:

If well telescopes please
sketch and show depths.

GROUND LEVEL

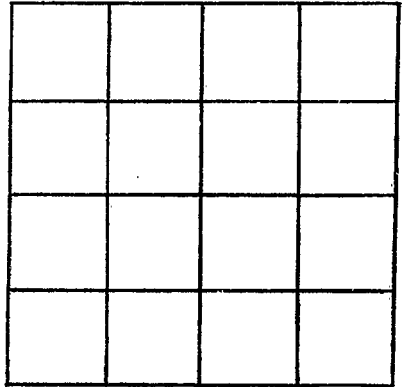

SECTION _____

Please indicate well location X.

ADDITIONAL INFORMATION

If more than one screen,
show locations of each on sketch.