

MISSISSIPPI DEPARTMENT OF NATURAL RESOURCE

Bureau of Land and Water Resources

Southport Mall

P.O. Box 10631

Jackson, Mississippi 39209

WATER WELL DRILLERS LOG

Griner Drilling Service, Inc.

CODED

Pearl River

PEARL RIVER
E 59
5-27-86

5-27-86

date well completed

firm name

county well located

LANDOWNER:

Prosper Energy
P.O. Box 4096
Houma, La. 70361
(mailing address)

description of formations encountered

from

to

clay
some sand

0 420

WELL LOCATION: 1500N 4 2500E

sec 13 T 2 N R 17 E of

No. 1 Crown Poplarville Field
2 1/2 miles (distance) S of (direction) (nearest town)

WELL PURPOSE: oilfield rig
13" (home, irrigation, municipal, industrial)

sand

420 440

sand


440 480

CODED

WELL COMPLETION DATA:

- (1) diameter (inches) 4"
- (2) total depth (feet) 480'
- (3) static water level (feet) 70' (below) above top of ground.
- (4) casing 480' steel (material) (depth)
4" (size) If telescope see back.
- (5) screen 42' 338' (length) (depth to top)
4" perforated (size) (material)
- (6) pump — 80 (HP) (yield gpm)
AC (type power)
- (7) electric log (yes or no)
- (organization running log)

No. 1 Water Well
on location

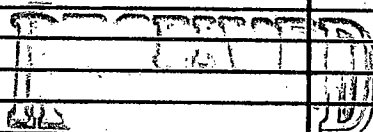

JUN 17 1986


Department of Natural Resources
BUREAU OF LAND AND WATER RESOURCES

(8) how well bottom plugged orange
peel

DRILLERS REMARKS:

If well telescopes please sketch and show depths.

GROUND LEVEL

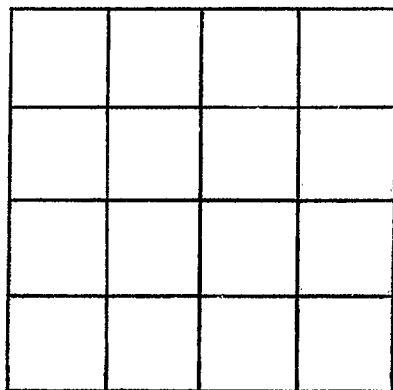

SECTION _____

Please indicate well location X.

ADDITIONAL INFORMATION

If more than one screen, show locations of each on sketch.