

MISSISSIPPI DEPARTMENT OF NATURAL RESOURCES

Bureau of Land and Water Resources

Southport Mall

P.O. Box 10631

Jackson, Mississippi 39209

WATER WELL DRILLERS LOG

Griner Drilling Service, INC. Pearl River

CODED

PEARL RIVER  
E60  
5-27-86

date well completed

firm name

county well located

LANDOWNER:

Prosper Energy  
P.O. Box 4096  
Houma, La. 70361  
(mailing address)

description of formations encountered

from to

clay streaked sand 0 440

WELL LOCATION: 1500N + 2500E

sec. 13 T 2 N R 17 E of SW 1/4

SAND 440 480

No. 1 Crownbach (distance) Poplarville (direction) (nearest town)


CODED

WELL PURPOSE: oilfield rig

WELL COMPLETION DATA:

- (1) diameter (inches) 4"
- (2) total depth (feet) 480'
- (3) static water level (feet) 70' below top of ground.
- (4) casing steel 480' (material) (depth)  
4" (size) if telescope see back.
- (5) screen 42' 338' (length) (depth to top)  
4" perforated (size) (material)
- (6) pump - 60 (HP) (yield gpm)  
AC (type power)
- (7) electric log (yes or no)

No. 2 Water Well on location

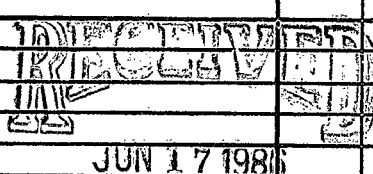

Department of Natural Resources  
Bureau of Land & Water Resources


(organization running log)

(8) how well bottom plugged orange

DRILLERS REMARKS:

If well telescopes please  
sketch and show depths.

GROUND LEVEL

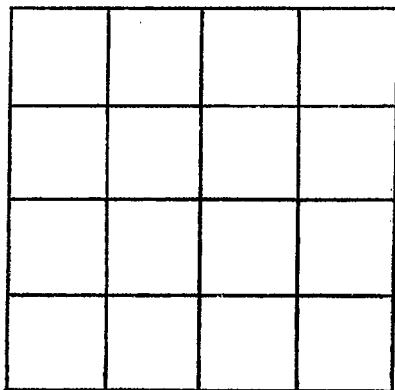

SECTION \_\_\_\_\_

Please indicate well location X.

ADDITIONAL INFORMATION

If more than one screen,  
show locations of each on sketch.